

**LAND CORNER RECORDATION CERTIFICATE**  
 Filing Requirement of Act 74, Mich. P.A. 1970

For corners in


Mackinac

(County)

Located in:

Corner Code #

1. Public Land Survey	T	R	_____
	T	R	_____
	T	R	_____
	T	R	_____
2. Property Controlling in Section	S 29	T 42N R 12W	5
	S 29	T 42N R 12W	6
3. Miscellaneous Property in Sec.	S	T R	_____
	S	T R	_____

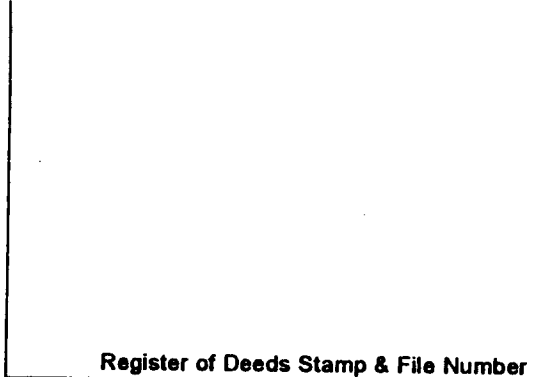

4. Lot No. \_\_\_\_\_, Recorded Plat \_\_\_\_\_  
 5. Private Claims \_\_\_\_\_

Feb 10 2005

I, Stephan J. Szyszkoski, in a field survey on \_\_\_\_\_, 19\_\_\_\_ do hereby state that under requirements of P.A. 74, Michigan P.A. of 1970, the corner points mentioned in lines 1 and 2 above were in conformance with regulations and rules therefore as required in the current manual of survey instructions of the United States Department of the Interior, Bureau of Land Management or by a decree of a Court of Law and /or that the corner points mentioned in lines 3, 4 and 5 above were in conformance with the rules of the Michigan Board of Land Surveyors or by a Decree of a Court of Law; established, re-established, monumented, recovered, found as expressed below:

**NOTE:** Not more than 2 corners, all in the same town and range, may be recorded on this certificate.

A	B	C	D	E	F	G	H	I	J	K	L	M
1												
2	6		5		4		3		2		1	
3												
4	7		8		9		10		11		12	
5												
6	18		17		16		15		14		13	
7												
8	19		20		21		22		23		24	
9												
10	30		29		28		27		26		25	
11												
12	31		32		33		34		35		36	
13												

**A. Description of original monument and accessories and/or subsequent restoration:**  
 (5-Sec. 29) North 1/16 corner, Section 29. Not established in the original survey.  
 (6-Sec. 29) Northeast 1/16 corner, Section 29. Not established in the original survey.


**B. Description of corner evidence found and/or method applied in restoring or reestablishing corner:**

(5-Sec. 29) Established the corner on a straight line between Center of Section 1323.47' south and Quarter corner 1323.47' north.  
 (6-Sec. 29) Established the corner at the intersection of straight lines connecting opposite 1/16 corners.

**C. Description of monument for corner and accessories established to perpetuate locating the position of the corner:**

(5) Set 1"IDx36" I.pipe with 4" alum. MDNR cap. Set nails with tags in:  
 8" Spruce N72E 23.55' mrkd "N1/16 BT"  
 5" W.Birch S70E 23.2' do  
 14" W.Birch S40E 23.6' do  
 7" Cedar S58W 107.8' do  
 Placed cedar post adjacent. Bearings are magnetic. Distances are to nail with tag.

(6) Set 1"IDx36" I.pipe with 4" alum. MDNR cap. Set nails with tags in:  
 5" Cedar N39W 9.4' mrkd "NE1/16 BT"  
 6" Cedar S12W 3.15' do  
 12" Cedar S86E 9.85' do  
 16" Tamarack S36E 18.0' do  
 Bearings are magnetic. Distances are to nail with tag.

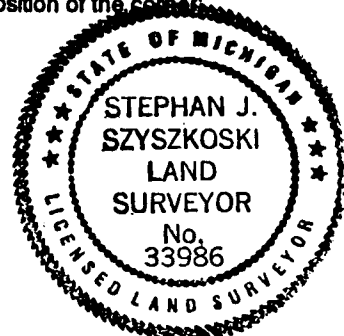

Signed by Stephan J. Szyszkoski  
 Surveyor's Michigan License No. 33986

Date 3/15/05