


SEC. 2, T. 47N. R. 9W, LUCE CO.

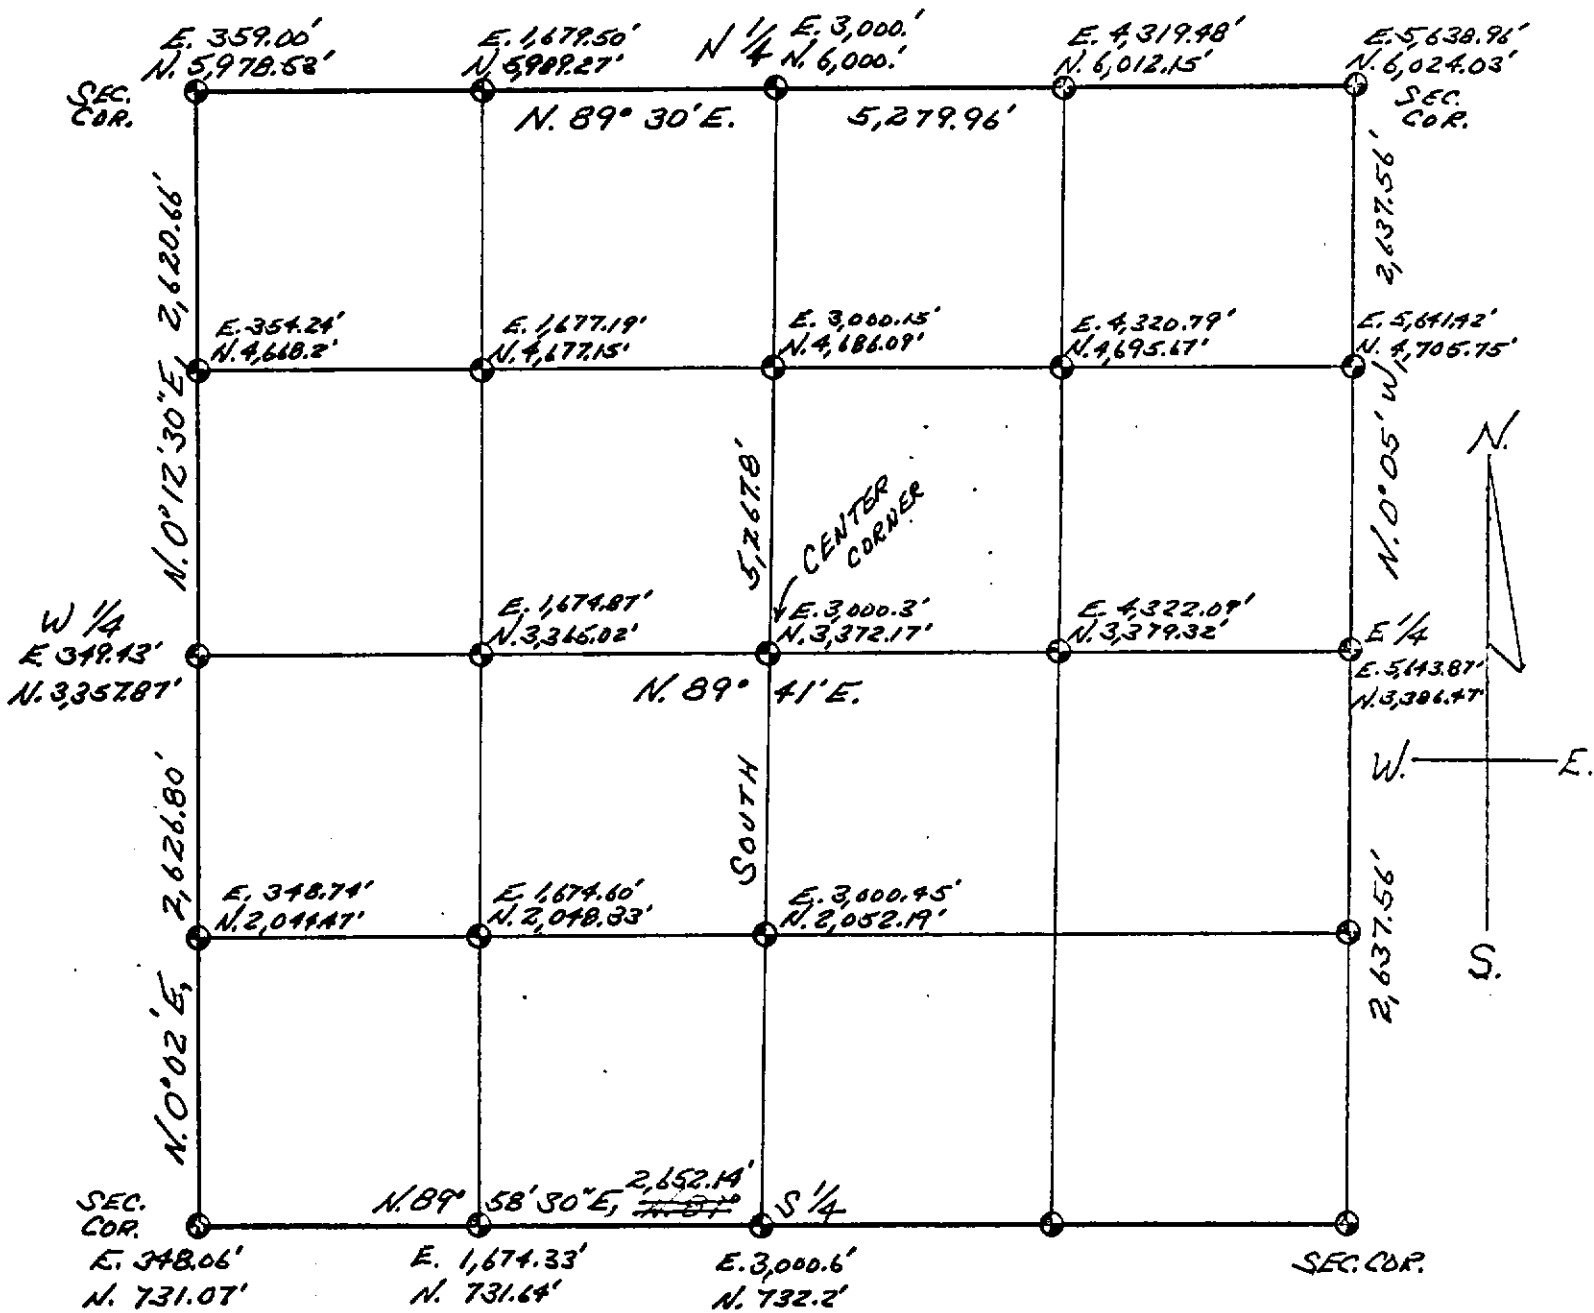

Sub-division of Section 2,
 showing
 Co-ordinates of Corners.
 Dept Markers placed at corners marked - - - -

Billy D. Buckler, P.L.S.