

LAND CORNER RECORDATION CERTIFICATE
Filing Requirement of Act 74, Mich. P.A. 1970 as Amended

For corners in

<u>Luce</u> (County)	Located In:	Corner Code #	
1. Public Land Survey	T _____ R _____	_____	_____
	T _____ R _____	_____	_____
	T _____ R _____	_____	_____
2. Property Controlling in Section	S <u>27</u> T <u>47N</u> R <u>9W</u>	<u>9</u>	_____
	S _____ T <u>47N</u> R <u>9W</u>	<u>H10</u>	_____
	S _____ T _____ R _____	_____	_____
3. Miscellaneous Property in Sec.	S _____ T _____ R _____	_____	_____
	S _____ T _____ R _____	_____	_____
4. Lot No. _____, Recorded Plat _____			
5. Private Claims			

Register of Deeds Stamp & File Number

1	A	B	C	D	E	F	G	H	I	J	K	L	M
2		6		5		4		3		2		1	
3													
4		7		8		9		10		11		12	
5													
6		18		17		16		15		14		13	
7													
8		19		20		21		22		23		24	
9													
10		30		29		28		27		26		25	
11													
12		31		32		33		34		35		36	
13													

I, Stephan J. Szyszkoski, in a field survey on 9 04/30/2008 do hereby state that under requirements of P.A. 74, Michigan P.A. of 1970, the corner points mentioned in lines 1 and 2 above were in conformance with regulations and rules therefore as required in the current manual of survey instructions of the United States Department of the Interior, Bureau of Land Management or by a decree of a Court of Law and /or that the corner points mentioned in lines 3, 4 and 5 above were in conformance with the rules of the Michigan Board of Land Surveyors or by a Decree of a Court of Law; established, re-established, monumented, recovered, found as expressed below:

NOTE: Not more than 2 corners, all in the same town and range, may be recorded on this certificate.

A. Description of original monument and accessories and/or subsequent restoration:

(9-Sec. 27) East 1/16 corner, Section 27. Not established in the original survey.

(H10) Center of Section 27. Not established in the original survey.

B. Description of corner evidence found and/or method applied in restoring or reestablishing corner:

(9-Sec. 27) Established the corner midway and on a straight line between Center of Section 1317.03' west and Quarter corner 1317.03' east.

(H10) Established the corner at the intersection of straight lines connecting opposite 1/4 corners.


C. Description of monument for corner and accessories established to perpetuate locating the position of the corner:

(9) Set 1"IDX36" I.pipe with 4" alum. MDNR cap. Set measuring nail with MDNR tag in the side of:
 8" J.Pine S58W 7.43' mrkd "E1/16 BT"
 8" W.Pine S25E 13.77' do
 7" J.Pine N54E 5.43' do
 Fd. a 3/4" I.pipe S16E 18.6'
 C/L trail, North 10'
 Bearings are magnetic.

(H10) Set 1"IDX36" I.pipe with 4" alum. MDNR cap. Set measuring nail with MDNR tag in the side of:
 10" R.Pine North 30.71' mrkd "C1/4 BT"
 6" B.Spruce S47W 17.29' do
 8" B.Spruce N80W 19.48' do
 12" R.Pine S06E 38.0' do
 Bearings are magnetic.

Signed by Stephan J. Szyszkoski
 Surveyor's Michigan License No. 33986

Date 09/08/2008

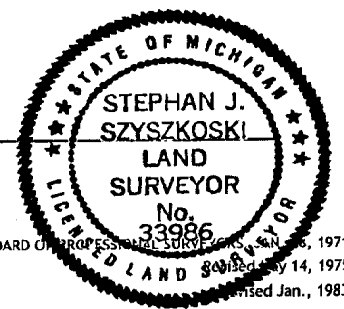

For the Michigan Department of Natural Resources, Office of Land and Facilities