

Lucas Co.

Trust Corner

FOR CORNERS OF--	LOCATED IN--	CORNER CODE NUMBER
1. PUBLIC LAND SURVEY	T. 47 N. S. R. 10 E. W.	I-13 16-Sec.34
2. PROPERTY CONTROLLING IN SECTION	34, T. 47 N. S. R. 10 E. W.	
3. MISCELLANEOUS PROPERTY IN SECTION	, T. S. R. E. W.	
4. LOT NO.	, RECORDED PLAT	
5. PRIVATE CLAIMS		

REGISTER OF DEEDS STAMP AND FILING NUMBER

I, Billy D. Buckler do hereby certify that under requirements of P.A. 74, Michigan P.A. of 1970, the corner points mentioned in lines 1 and 2 above (identified with circles on index code diagram - over) were, in a field survey on 1/29 1975, established, re-established, monumented, re-monumented, recovered or restored as expressed below and in conformance with regulations and rules therefore as required in the current manual of survey instructions of the United States Department of the Interior, Bureau of Land Management or by a decree of a court of law. Furthermore, that the corner points mentioned in lines 3, 4 and 5 above were, in a field survey on 19, found, recovered, restored, established or re-established as expressed below and in conformance with the rules of the Michigan State Board of Registration for Land Surveyors or, by a Decree of a Court of law:

A. Description of original monument and accessories and/or subsequent restoration:
 I-13 Sec. Cor. bet. Sec's. 34-35, T47N R10W and to Sec's. 2-3 T46N R10W set by Geo. b. Cannon D.S. in 1853.
 Bearings were: Hemlock 14", N46°E, 27 lks. and Hemlock 18", N65°W, 30 lks.


16-Sec.34 East 1/16 Cor. on Southside of Section 34.

B. Description of corner evidence found and/or method applied in restoring or re-establishing corner:
 I-13 Placed Corner by single proportionate measure along township line, in North edge of County Road.
 16-Sec.34 Sec. 34, East 1/16 Corner placed by single proportionate measure.

C. Description of monument for corner and accessories established to perpetuate locating the position of the corner:
 Drove Iron in road to mark both corners.
 I-13 New Witnesses: Power Pole, N27°W, 33.9' and 1 1/4" pipe, S47°E, 61.7'
 16-Sec.34 New Witnesses: 10" W. Birch, N20°W, 62.8' and 10" Aspen, N10°E, 55.3'

SIGNED BY Billy D. Buckler DATE 4-25-75

SURVEYOR'S MICHIGAN REGISTRATION NO. 8887

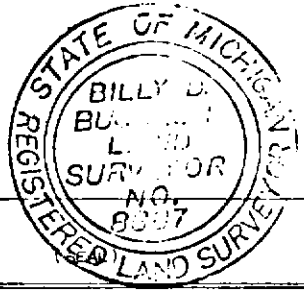

FOR STATE AND UNITED STATES AGENCIES:

SIGNED BY _____ DATE _____
CHIEF OF SURVEY PARTY

APPROVED AND SIGNED BY _____ DATE _____
MICHIGAN REGISTERED LAND SURVEYOR

(SEAL)

SURVEYOR'S MICHIGAN REGISTRATION NO. _____