


T 47 N R 10 W SECTION 19

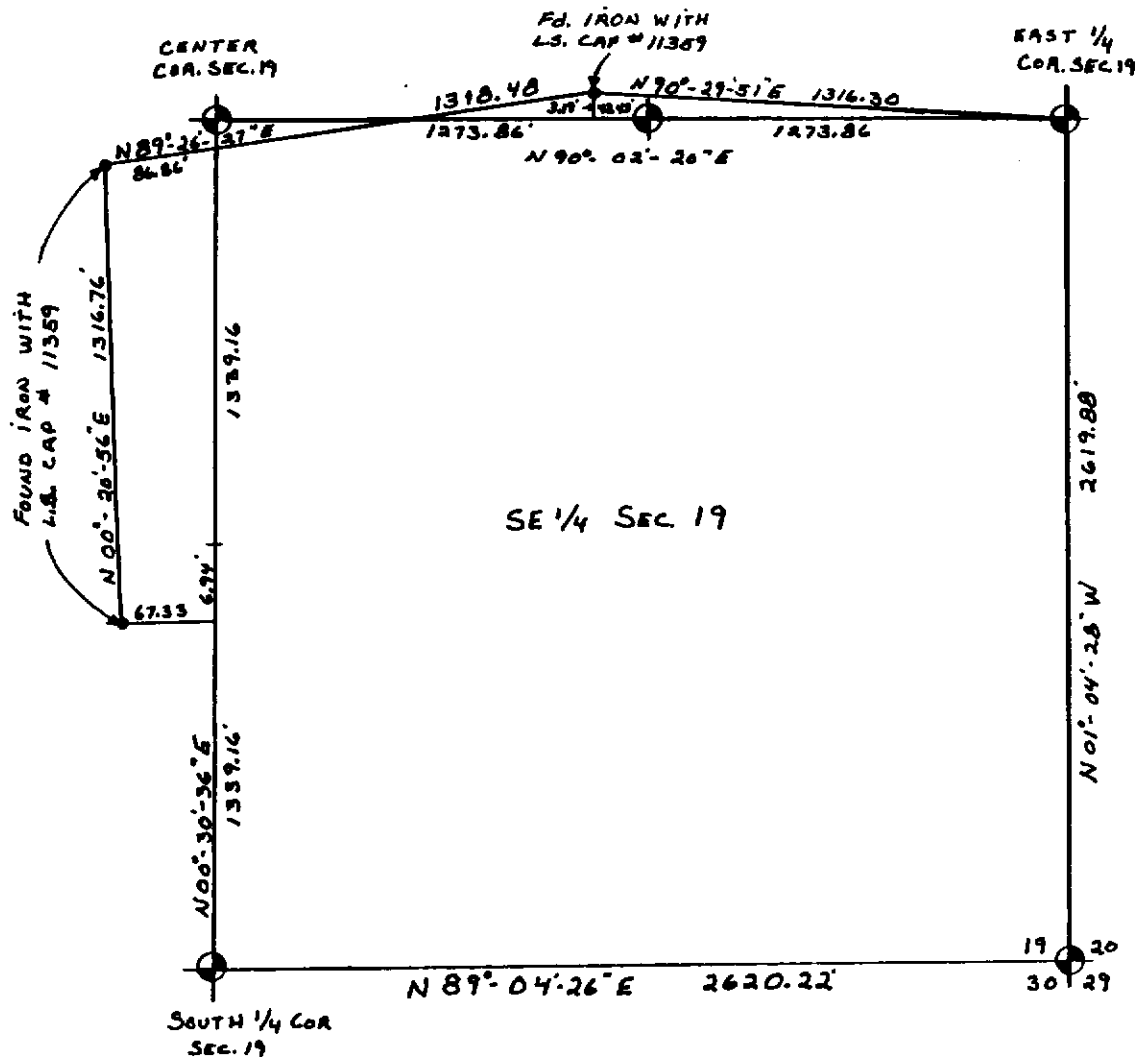

• D.N.R. MOUMENT

NO SCALE

• MONUMENTS BY L.S. 11359
RECORDED UNDER ACT # 132

Genell L. Wiggins
L.S. 23521