

**LAND CORNER RECORDATION CERTIFICATE**  
 Filing Requirement of Act 74, Mich. P.A. 1970

For corners in  

(County)	Located In:	Corner Code #/1
1. Public Land Survey	T 47NR 10W	E13
	T 47NR 10W	E12
	T 47NR 10W	G11
2. Property Controlling in Section	T R	
	S T R	
3. Miscellaneous Property in Sec.	S T R	
	S T R	

Register of Deeds Stamp & File Number


4. Lot No. \_\_\_\_\_, Recorded Plat \_\_\_\_\_  
 5. Private Claims \_\_\_\_\_

G11 March 23, 1994

E12 April 25, 1994

I, Stephan J. Szyszkoski, in a field survey on E13 September 06, 1994, 19\_\_\_\_\_, do hereby certify that under requirements of P.A. 74, Michigan P.A. of 1970, the corner points mentioned in lines 1 and 2 above were in conformance with regulations and rules thereto as required in the current manual of survey instructions of the United States Department of the Interior, Bureau of Land Management or by a decree of a Court of Law and/or that the corner points mentioned in lines 3, 4 and 5 above were in conformance with the rules of the Michigan Board of Land Surveyors or by a Decree of a Court of Law, established, re-established, monumented, re-monumented, recovered, found as expressed below:

**NOTE:** Not more than 4 corners, all in the same town and range, may be recorded on this certificate.

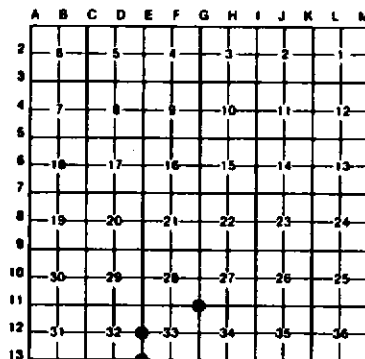

**A. Description of original monument and accessories and/or subsequent restoration:**

(E13) Corner common to Sections 32-33 T47N-R10W and Sections 4-5 T46N-R10W. Corner reestablished in 1960 by Billy D. Buckler, RLS, by single proportionate measurement along the township line. 1960 witnesses are 12" Soft Maple S07E 82 links. 8" Soft Maple N20E 62.5 links. Position falls in center of blacktop road. Buckler buried a 1/2"x36" iron bar at the corner position.

(E12) Quarter corner common to Sections 32-33. Corner reestablished in 1977 by Billy D. Buckler, RLS, as follows: Corner restored midway and on line between two Section Corners. Found no evidence of original corner. Placed 1" pipe with 4" aluminum cap at corner. New bearings 8" R. Maple S75W 5.2', 8" Twin R. Maple S35E 14.0'.

(G11) Corner common to Sections 27-28-33-34. Corner re-monumented in 1964 by Frank J. Bray, RLS, from original Cedar bearing tree N45W 19 links. Corner monument placed was 1" iron pipe with 4" aluminum cap. NBTs: 8" Cedar S48E 36.5 links, 6" Cedar S42W 28 links.

**B. Description of corner evidence found and/or method applied in restoring or reestablishing corner:**

(E13) Found and accepted Buckler's monument at record bearing and distance from the remaining NBT - the 12" Soft Maple Southeast, now dead. The 2nd NBT had been removed. The 1/2" iron bar monument was found in the center of the paved Co. Rd 407. Made 4 new witnesses as described below.

(E12) Found Buckler's monument as described, in good condition, at record bearing and distance from both his 1977 witnesses, both in good condition. Marked new top blazes in these and marked two additional witnesses as described below. Determined the monument to be 1.89' West and 0.50' South of the position proportionate to the original record and accepted same as a careful and faithful reestablishment of the position of the original corner.

(G11) Found and accepted Bray's monument, in good condition, and at record bearing and distance from the remaining NBT cedar Southwest and from the stump of the original cedar bearing tree noted above. The second cedar NBT is now down. Left the monument in place and marked new bearing trees as described below.

**C. Description of monument for corner and accessories established to perpetuate locating the position of the corner:**

(E13) Found 1/2" iron bar below pavement. Set nails with MDNR tags in the following two witnesses:

Power pole N55E 71.9'  
 6" Maple N35E 93.2' marked "S33 NBT"  
 USGS Concrete Monument S50E 84.0'  
 Triangular concrete MDN marker marked "S2859" N72W 153.8'.  
 Bearings are magnetic.

(E12) Found 1" iron pipe with 4" MDNR cap. Blazed, scribed, and set measuring nails in the following:

10" R. Maple S75W 5.4' "1/4S"  
 10" Twin R. Maple S35E 14.7' "1/4S"  
 8" R. Pine N35E 40.0' "1/4S NBT"  
 6" R. Pine N71E 58.5' "1/4S NBT"  
 Placed a 6" squared and scribed cedar post adjacent. Bearings are magnetic.

(G11) Found 1" iron pipe with 4" Aluminum cap. Blazed, scribed, and set measuring nails in the following:

7" Cedar S42W 18.5' "S33"  
 8" Cedar S72E 11.3' "S34 NBT"  
 5" Cedar N02E 16.2' "S27 NBT"  
 12" Cedar S22W 18.8' "S33 NBT"  
 Placed a 5" cedar post adjacent.  
 Bearings are magnetic.

Signed by

*Stephan J. Szyszkoski*

Date 10-17-94

Surveyor's Michigan License No.

33986

FORM APPROVED BY MICHIGAN STATE DEPARTMENT OF NATURAL RESOURCES - FOREST MANAGEMENT DIVISION  
 For the Michigan Department of Natural Resources - Forest Management Division

