80

LAND CORNER RECORDATION CERTIFICATE

Filing Requirement of Act 74, Mich. P.A. 1970

For corners in Luce (County)

	Located In:	Corner Code ##
1. Public Land Survey	T ____ R ____	
	T ____ R ____	
	T ____ R ____	
	T ____ R ____	
2. Property Controlling	S 6 T 47N R 10W	9
in Section	S 6 T 47N R 10W	6
3. Miscellaneous	S ____ T ____ R ____	
Property in Sec.	S ____ T ____ R ____	

Register of Deeds Stamp & File Number

4. Lot No. _____ , Recorded Plat _____
5. Private Claims _____

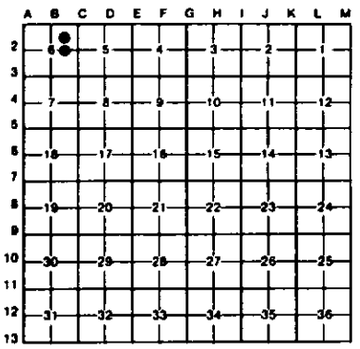

I, Stephan J. Szyszkoski, in a field survey on 6 May 08, 1995 9 June 07, 1995, 19 _____, do hereby certify that under requirements of P.A. 74, Michigan P.A. of 1970, the corner points mentioned in lines 1 and 2 above were in conformance with regulations and rules therefore as required in the current manual of survey instructions of the United States Department of the Interior, Bureau of Land Management or by a decree of a Court of Law and/or that the corner points mentioned in lines 3, 4 and 5 above were in conformance with the rules of the Michigan Board of Land Surveyors or by a Decree of a Court of Law; established, re-established, monumented, re-monumented, recovered, found as expressed below:

NOTE: Not more than 4 corners, all in the same town and range, may be recorded on this certificate.

A. Description of original monument and accessories and/or subsequent restoration:

(9-Sec. 6) East 1/16 corner, Section 6. Corner not established in the original survey. Found no subsequent record.
(6-Sec. 6) Northeast 1/16 corner Section 6. Corner not established in the original survey. Found no subsequent record.

B. Description of corner evidence found and/or method applied in restoring or reestablishing corner:

(9-Sec. 6) Found no evidence of prior monumentation at the corner position. Established the corner on a straight line between Center of Section 1317.78' West and 1/4 corner 1317.78' East. At the position for the corner, I placed a 1"I.D.x32" iron pipe capped with a 4" dia. cast aluminum MDNR tablet, appropriately stamped. From the corner monumented, I found a 1/2" iron pipe placed by unknown persons, 53.16' east, 2.79' south of the 1/4 line.
(6-Sec. 6) Found no evidence of prior monumentation at the corner position. Established the corner at the intersection of straight lines connecting opposite 1/16 corners, being 1475.39' north, 1322.22' east, 1316.26' south, and 1321.06' west. At the position for the corner, I placed a 1"I.D.x32" iron pipe capped with a 4" dia. cast aluminum MDNR tablet, appropriately stamped.

C. Description of monument for corner and accessories established to perpetuate locating the position of the corner:

(9) Set 1"pipe with a 4" MDNR cap. Blazed, scribed, and set measuring nails in the following bearing trees:

6" Spruce S54E 24.9'	"E1/16 BT"
12" W. Birch S10W 23.8'	"E1/16 BT"
3" Maple S16W 15.95'	"E1/16 BT"
4" Maple N29W 7.7'	"E1/16 BT"

Placed a 4"x4" blue post adjacent. Bearings are magnetic.

(6) Set 1" pipe with 4" MDNR cap. Blazed, scribed, and set measuring nails in the following:

6" Maple S70W 18.9'	"NE1/16 BT"
8" Maple S12W 25.6'	"NE1/16 BT"
5" Maple S47E 6.7'	"NE1/16 BT"
Twin 6" Maple N50E 22.7'	"NE1/16 BT"

Placed a 5" squared and scribed cedar post adjacent. Bearings are magnetic.

STATE OF MICHIGAN
STEPHAN J. SZYSZKOSKI
LAND SURVEYOR
No. 33986
LICENSED LAND SURVEYOR

Signed by Stephan J. Szyszkoski Date 8/28/95

Surveyor's Michigan License No. 33986

For the Michigan Department of Natural Resources - Forest Management Division

FORM APPROVED BY MICHIGAN STATE BOARD OF LAND SURVEYORS, JAN. 28, 1971
REVISED MAY 14, 1975
REVISED JAN., 1983