

LAND CORNER RECORDATION CERTIFICATE
Filing Requirement of Act 74, Mich. P.A. 1970

For corners in
Luce

(County)

Located In: Corner Code #

1. Public Land Survey	T	<u>47N</u>	R	<u>10W</u>	<u>I12</u>
	T		R		
	T		R		
	T		R		
2. Property Controlling in Section	S		T		
	S		T		
3. Miscellaneous Property in Sec.	S		T		
	S		T		

Register of Deeds Stamp & File Number

4. Lot No. _____, Recorded Plat _____
 5. Private Claims _____

Jun 04 2002

I, Stephan J. Szyszkoski, in a field survey on _____, 19____ do hereby state that under requirements of P.A. 74, Michigan P.A. of 1970, the corner points mentioned in lines 1 and 2 above were in conformance with regulations and rules therefore as required in the current manual of survey instructions of the United States Department of the Interior, Bureau of Land Management or by a decree of a Court of Law and /or that the corner points mentioned in lines 3, 4 and 5 above were in conformance with the rules of the Michigan Board of Land Surveyors or by a Decree of a Court of Law; established, re-established, monumented, recovered, found as expressed below:

NOTE: Not more than 2 corners, all in the same town and range, may be recorded on this certificate.


	A	B	C	D	E	F	G	H	I	J	K	L	M
1													
2		6		5		4		3		2		1	
3													
4		7		8		9		10		11		12	
5													
6		18		17		16		15		14		13	
7													
8		19		20		21		22		23		24	
9													
10		30		29		28		27		26		25	
11													
12		31		32		33		34	●	35		36	
13													

A. Description of original monument and accessories and/or subsequent restoration:
 (I12) Quarter corner common to Sections 34-35. 1853: Established by Geo. H. Cannon: N6'E corrected...40.60 Set quarter Section post. Tamarac 10 N52W 34, Tamarac 6 S70E 34.5...81.20 Corner of Sects 26,27,34,35.

B. Description of corner evidence found and/or method applied in restoring or reestablishing corner:
 (I12) The original post and accessories were not recovered. Reestablished the corner midway and on a line of mean true bearing between Section corners 2669.01' north and south, being in proportion to the original record.

C. Description of monument for corner and accessories established to perpetuate locating the position of the corner:

(I12) Set 1"IDx36" I.pipe with 4" alum. MDNR cap. Blazed, scribed, and set measuring nails in:
 4" Tamarack N85E 23.65' "1/4S NBT"
 6" W.Birch N10E 9.9' do
 5" W.Birch S83W 14.05' do
 5" Maple S18W 17.95' do
 Set cedar post adjacent. Bearings are magnetic. Distances are to nail with tag.

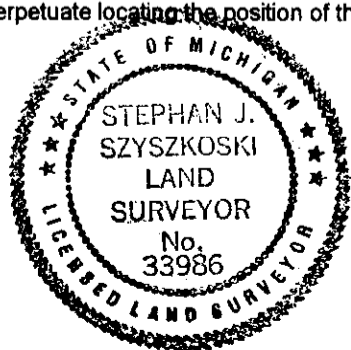

Signed by Stephan J. Szyszkoski Date 8/6/02
 Surveyor's Michigan License No. 33986