

LAND CORNER RECORDATION CERTIFICATE
Filing Requirement of Act 74, Mich. P.A. 1970 as Amended

For corners in

<u>Luce</u> (County)	Located In:	Corner Code #
1. Public Land Survey	T47N R 10W	C11
	T ___ R ___	_____
	T ___ R ___	_____
2. Property Controlling in Section	S ___ T ___ R ___	_____
	S ___ T ___ R ___	_____
3. Miscellaneous Property in Sec.	S ___ T ___ R ___	_____
	S ___ T ___ R ___	_____
4. Lot No. _____, Recorded Plat _____		
5. Private Claims		

Register of Deeds Stamp & File Number

1	A	B	C	D	E	F	G	H	I	J	K	L	M
2		6		5		4		3		2		1	
3													
4		7		8		9		10		11		12	
5													
6		18		17		16		15		14		13	
7													
8		19		20		21		22		23		24	
9													
10		30		29		28		27		26		25	
11													
12		31		32		33		34		35		36	
13													


I, Stephan J. Szyszkoski, in a field survey on June 18, 2007 do hereby state that under requirements of P.A. 74, Michigan P.A. of 1970, the corner points mentioned in lines 1 and 2 above were in conformance with regulations and rules therefore as required in the current manual of survey instructions of the United States Department of the Interior, Bureau of Land Management or by a decree of a Court of Law and /or that the corner points mentioned in lines 3, 4 and 5 above were in conformance with the rules of the Michigan Board of Land Surveyors or by a Decree of a Court of Law; established, re-established, monumented, recovered, found as expressed below:

NOTE: Not more than 2 corners, all in the same town and range, may be recorded on this certificate.

A. Description of original monument and accessories and/or subsequent restoration:
 (C11) Corner common to Sections 29-30-31-32. 1853 - Remonumented by Geo. Cannon, Deputy Surveyor. Set post (same point as old 1/4 cor. Old BTs Sugar 17 N42E 39 links, Sugar 17 S12E 35 links). New BTs Y.Birch 26 N50W 45 links, Sugar 13 S11E 35 links. 1957 - Remonumented by Billy D. Buckler RLS at location of found 3/4" iron pin and wood stake. Position checks very good to pond and line tree to north and to pond and marsh to east. Found stump holes in proper position for bearing trees. Set 1" pipe with 4" brass cap. 10" Hard Maple S55W 77.5 links, 9" Elm N43W 108 links.

B. Description of corner evidence found and/or method applied in restoring or reestablishing corner:
 (C11) Recovered the 1957 monument in good condition and at record bearing and distance from the remaining NBT Sugar Maple S55W, found in good condition. The Elm NBT was not recovered. Accepted the monument as a careful and faithful perpetuation of the position of the original corner.

C. Description of monument for corner and accessories established to perpetuate locating the position of the corner:
 (C11) Found 1" ID I.pipe with 4" brass MI Dept. of Conservation tablet. Set measuring nail with yellow plastic MDNR tag in the side of the following:
 22" Sugar S62W 51.0' mrkd "S31" (1957 NBT)
 14" R.Pine N16E 57.6' mrkd "S29 NBT"
 10" twin Spruce N88W 16.6' "S30 NBT"
 Power Pole '209X' S43E 38.2'
 Bearings are magnetic. Distances are to nail with tag.

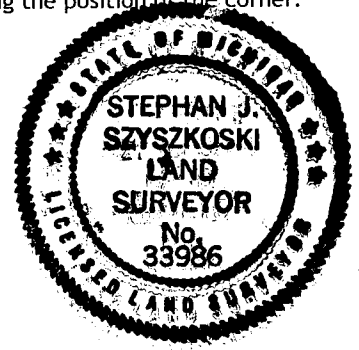

Signed by Stephan J. Szyszkoski Date 12/20/07

Surveyor's Michigan License No. 33986