


SKETCH OF
 SEC. 34, T47N R11W
 LUCE CO.

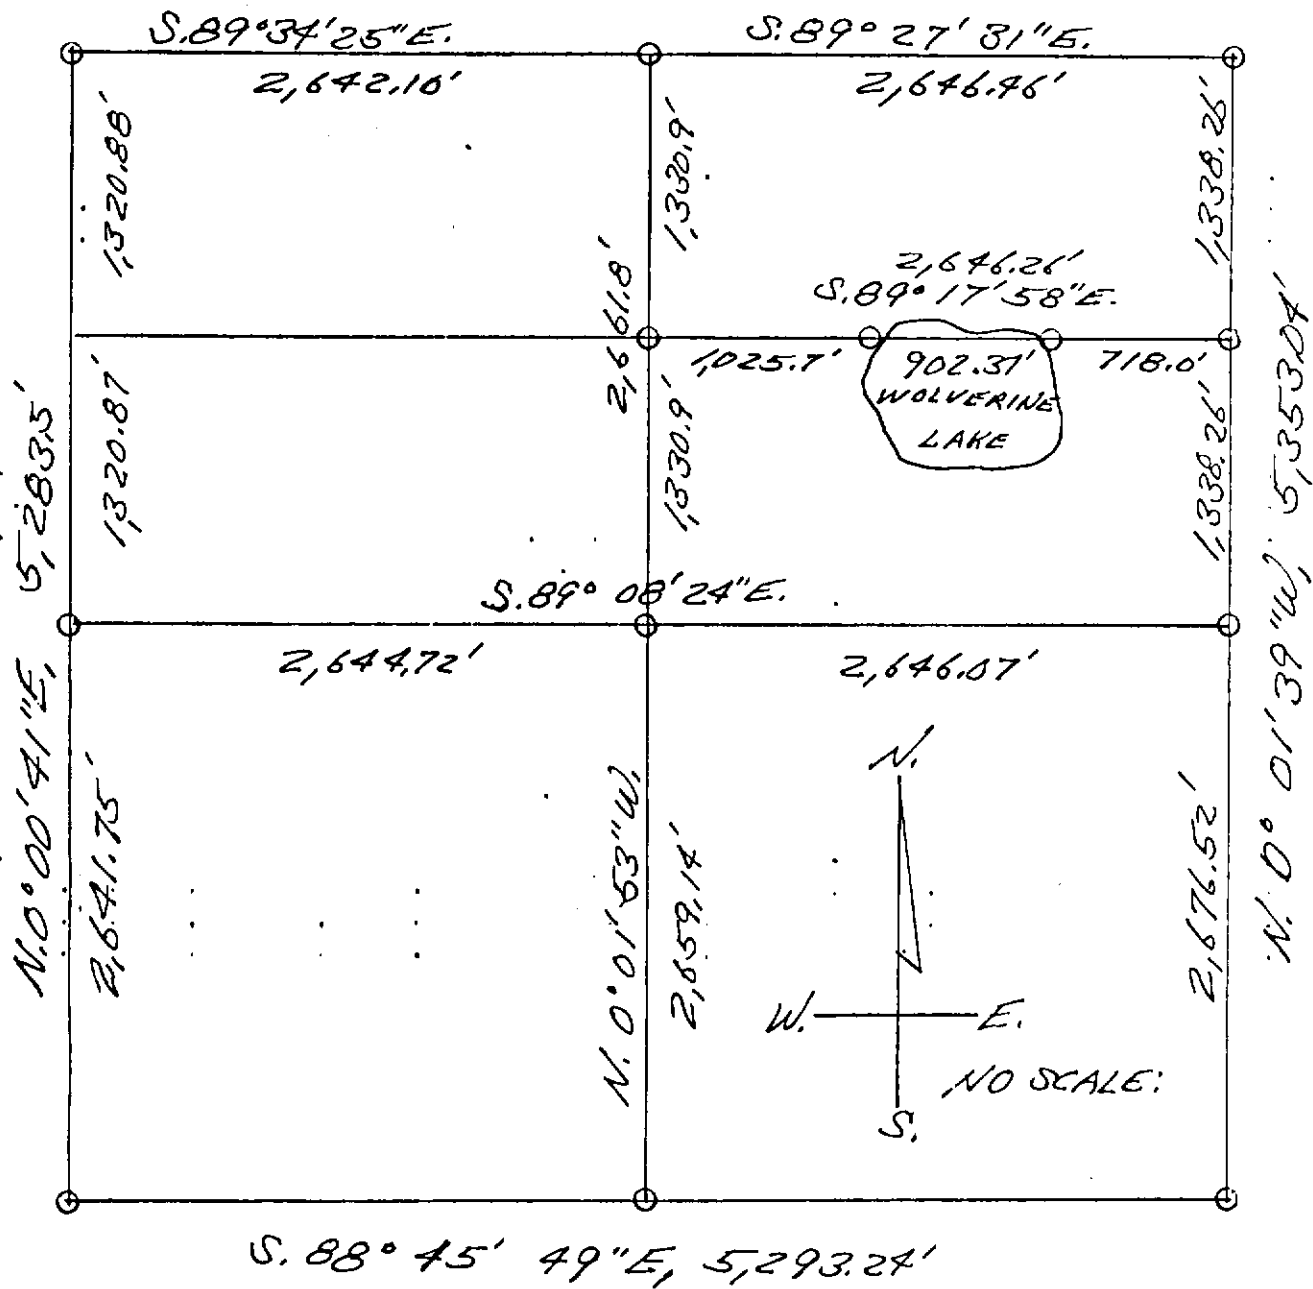

9-12-78

BILLY D. BUCKLER
 REG. LAND SURVEYOR
 # 8887.