



SKETCH OF  
SEC. 13, T47N R11W  
LUCE CO.

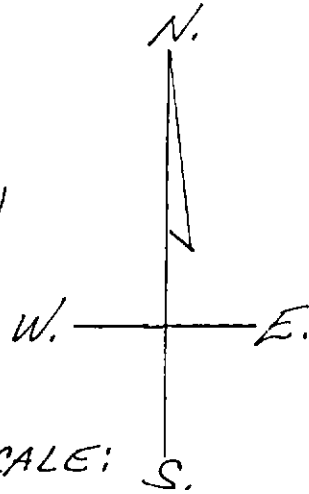

NO SCALE: S.

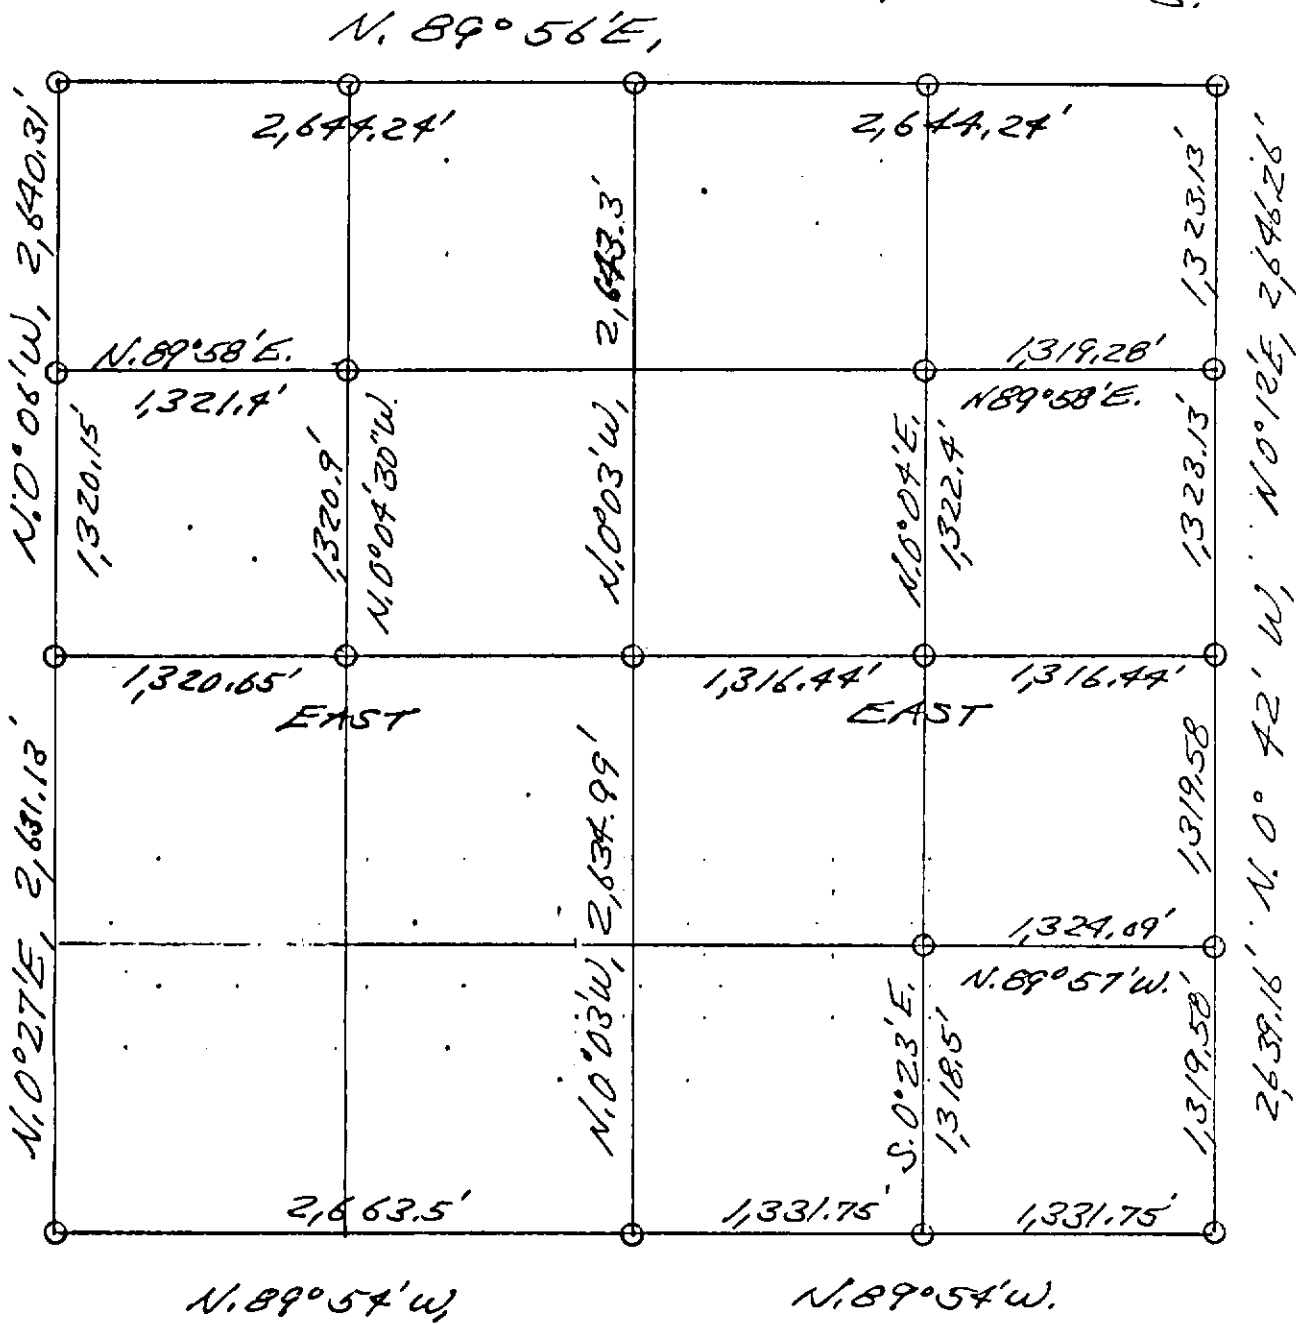

9-12-78  
BILLY D. BUCKLER  
REG. LAND SURVEYOR  
# 8887.