LAND CORNER RECORDATION CERTIFICATE

Filing Requirement of Act 74, Mich. P.A. 1970

For corners in

LUCE
(County)

		Located In:		Corner Code #/
1. Public Land Survey		T 47N	R 11W	I-7
		T 47N	R 11W	I-8
		T 47N	R 11W	H-7
		T 47N	R 11W	G-8
2 Property Controlling	S	T	R	
in Section	S	T	R	
3 Miscellaneous	S	T	R	
Property in Sec	S	T	R	

Register of Deeds Stamp & File Number

4 Lot No _____, Recorded Plat _____

5. Private Claims _____

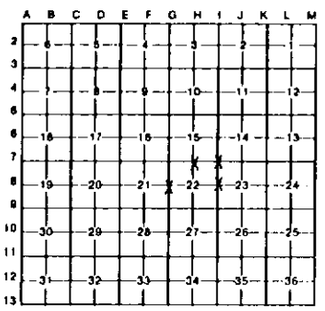

I, GERALD L. WIGGINS, in a field survey on 6-28 & 7-10, 19 89, do hereby certify that under requirements of P.A. 74, Michigan P.A. of 1970, the corner points mentioned in lines 1 and 2 above were in conformance with regulations and rules therefore as required in the current manual of survey instructions of the United States Department of the Interior, Bureau of Land Management or by a decree of a Court of Law and/or that the corner points mentioned in lines 3, 4 and 5 above were in conformance with the rules of the Michigan Board of Land Surveyors or by a Decree of a Court of Law, established, re-established, monumented, re-monumented, recovered, found as expressed below

NOTE: Not more than 4 corners, all in the same town and range, may be recorded on this certificate.

A. Description of original monument and accessories and/or subsequent restoration:

I-7 N.E. Section Corner of Section 22. OBT'S: 10" Y. Birch, N65°E, 77 lks. & 14" Maple, S74°W, 22 lks.

I-8 East 1/4 Corner of Section 22. OBT'S: 24" W. Pine, North, 40 1/2 lks. & 18" W. Pine, S29°W, 40 lks.

H-7 North 1/4 Corner of Section 22. OBT'S: 10" Hemlock, S70°W, 26 lks. & 14" Maple, N21 1/2°E, 1.13 chs.

G-8 West 1/4 Corner of Section 22. OBT'S: 16" W. Pine, N15°W, 61 lks. & 12" W. Pine, N71°E, 70 lks.

B. Description of corner evidence found and/or method applied in restoring or reestablishing corner:

I-7 Corner set by double proportionate measure between 1/4 Corner 1/2 mile North, Section Corner 1 mile South and Section Corners 1 mile East and West.

I-8 Corner set by single proportionate measure between Section Corners 1/2 mile North and South.

H-7 Corner set by single proportionate measure between Section Corners 1/2 mile East and West. A small pond and a small water settle mentioned in original notes fit this position.

G-8 Corner set by single proportionate measure between N.W. Corner and S.W. Corner of Section 22.

C. Description of monument for corner and accessories established to perpetuate locating the position of the corner:

DNR MONUMENTS SET AT ALL FOUR CORNERS.

I-7 18" W. Pine, S40°E, 21.7'
8" J. Pine, S10°W, 70.5'
5" W. Pine, N49°W, 52.2'
6" Cherry, N15°E, 57.3'

I-8 10" W. Pine, S48°W, 5.35'
12" W. Pine, N82°W, 35.15'
12" W. Pine, N13°E, 28.70'
8" W. Pine, S60°E, 21.60'

H-7 8" S.Maple, N71°W, 39.9'
10" S.Maple, N21°E, 16.4'
14" W.Birch, N72°E, 18.7'
6" S.Maple, S21°E, 12.0'

G-8 8" W. Pine, N23°E, 32.6'
6" W. Pine, S61°E, 23.3'
10" W. Pine, S18°W. 34.5'
10" W. Pine, N43°W, 26.0'

STATE OF MICHIGAN
GERALD L. WIGGINS
LAND SURVEYOR
No. 23521
REGISTERED LAND SURVEYOR

Signed by Gerald L. Wiggins Date 10-10-89

Surveyor's Michigan License No. 23521

FORM APPROVED BY MICHIGAN STATE BOARD OF LAND SURVEYORS, JAN 28 1971
REVISED MAY 14, 1975
REVISED JAN., 1983