

**LAND CORNER RECORDATION CERTIFICATE**  
**Filing Requirement of Act 74, Mich. P.A. 1970 as Amended**

For corners in

Luce	Located In:	Corner Code #
(County)		
1. Public Land Survey	T _____ R _____	_____
	T _____ R _____	_____
	T _____ R _____	_____
2. Property Controlling in Section	S <u>32</u> T <u>47N</u> R <u>11W</u>	<u>1</u>
	S <u>32</u> T <u>47N</u> R <u>11W</u>	<u>8</u>
	S _____ T _____ R _____	_____
3. Miscellaneous Property in Sec.	S _____ T _____ R _____	_____
	S _____ T _____ R _____	_____
4. Lot No. _____, Recorded Plat _____		
5. Private Claims _____		

Register of Deeds Stamp & File Number

	A	B	C	D	E	F	G	H	I	J	K	L	M
1													
2		6		5		4		3		2		1	
3													
4		7		8		9		10		11		12	
5													
6		18		17		16		15		14		13	
7													
8		19		20		21		22		23		24	
9													
10		30		29		28		27		26		25	
11													
12		31		32		33		34		35		36	
13													

I, Stephan J. Szyszkoski, in a field survey on 8 10/07/2010 do hereby state that under requirements of P.A. 74, Michigan P.A. of 1970, the corner points mentioned in lines 1 and 2 above were in conformance with regulations and rules therefore as required in the current manual of survey instructions of the United States Department of the Interior, Bureau of Land Management or by a decree of a Court of Law and /or that the corner points mentioned in lines 3, 4 and 5 above were in conformance with the rules of the Michigan Board of Land Surveyors or by a Decree of a Court of Law; established, re-established, monumented, recovered, found as expressed below:

**NOTE:** Not more than 2 corners, all in the same town and range, may be recorded on this certificate.

**A. Description of original monument and accessories and/or subsequent restoration:**

(1-Sec. 32) West 1/16 corner between Sections 29 and 32. Not established in the original survey.

(8-Sec. 32) West 1/16 corner, Section 32. Not established in the original survey.

**B. Description of corner evidence found and/or method applied in restoring or reestablishing corner:**

(1-Sec. 32) Established the corner midway and on the Section line between Section corner 1326.76' west and Quarter corner 1326.76' east.

(8-Sec. 32) Established the corner midway and on a straight line between Quarter corner 1323.91' west and the intersection of Quarter lines of Section 32 1323.91' east.


**C. Description of monument for corner and accessories established to perpetuate locating the position of the corner:**

(1) Set 1"IDx36" I.pipe with 4" alum. MDNR cap. Set measuring nail with MDNR tag in the side of:  
 14" Maple S69E 13.25' mrkd "W1/16 BT"  
 9" Sugar N35E 18.7' do  
 8" Maple N52W 29.9' do  
 6" Sugar N74W 7.35' do  
 Bearings are magnetic.

(8) Set 1"IDx36" I.pipe with 4" alum. MDNR cap. Set measuring nail with MDNR tag in the side of:  
 19" Maple N27E 18.15' mrkd "W1/16 BT"  
 10" twin Maple S36W 13.2' do  
 21" Y.Birch N78W 34.8' do  
 4" Maple S46E 25.5' do  
 Bearings are magnetic.

Signed by Stephan J. Szyszkoski  
 Surveyor's Michigan License No. 33986

Date 11/16/2010

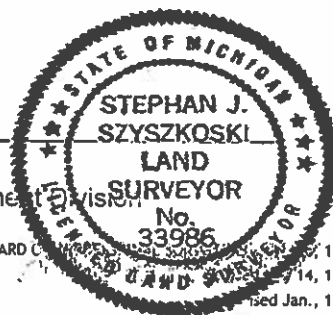

For the Michigan Department of Natural Resources and Environment, Forest Management Division