

**LAND CORNER RECORDATION CERTIFICATE**  
**Filing Requirement of Act 74, Mich. P.A. 1970**

For corners in

Luce

(County)

Located In:

Corner Code #

1. Public Land Survey

T 47N R 11W H11

T 47N R 11W III

T \_\_\_\_\_ R \_\_\_\_\_ \_\_\_\_\_

T \_\_\_\_\_ R \_\_\_\_\_ \_\_\_\_\_

2. Property Controlling  
in Section

S \_\_\_\_\_ T \_\_\_\_\_ R \_\_\_\_\_

S \_\_\_\_\_ T \_\_\_\_\_ R \_\_\_\_\_

3. Miscellaneous  
Property in Sec.

S \_\_\_\_\_ T \_\_\_\_\_ R \_\_\_\_\_

S \_\_\_\_\_ T \_\_\_\_\_ R \_\_\_\_\_

Register of Deeds Stamp & File Number

4. Lot No. \_\_\_\_\_, Recorded Plat \_\_\_\_\_

5. Private Claims \_\_\_\_\_

Aug 11 2003

I, Stephan J. Szyszkoski, in a field survey on \_\_\_\_\_, 20\_\_\_\_ do hereby state that under requirements of P.A. 74, Michigan P.A. of 1970, the corner points mentioned in lines 1 and 2 above were in conformance with regulations and rules therefore as required in the current manual of survey instructions of the United States Department of the Interior, Bureau of Land Management or by a decree of a Court of Law and /or that the corner points mentioned in lines 3, 4 and 5 above were in conformance with the rules of the Michigan Board of Land Surveyors or by a Decree of a Court of Law; established, re-established, monumented, recovered, found as expressed below:

NOTE: Not more than 2 corners, all in the same town and range, may be recorded on this certificate.

	A	B	C	D	E	F	G	H	I	J	K	L	M
1													
2	6		5		4		3		2		1		
3													
4	7		8		9		10		11		12		
5													
6	18		17		16		15		14		13		
7													
8	19		20		21		22		23		24		
9													
10	30		29		28		27		26		25		
11													
12	31		32		33		34		35		36		
13													

A. Description of original monument and accessories and/or subsequent restoration:  
(H11) Quarter corner common to Sections 27-34. 1971: Remonumented from two probable pine witnesses by Billy D. Buckler, RLS. Set 1" pipe with 4" aluminum cap. 9" W.Pine S07W 9.5', 12" W.Pine N85E 43.6'  
(I11) Corner common to Sections 26-27-34-35. 1960: Billy D. Buckler found H. Lawrence corner and set 1" pipe with 4" brass cap. 24" W.Pine S43W 270.5 links, 36" W.Pine stub N85E 76 links.

B. Description of corner evidence found and/or method applied in restoring or reestablishing corner:

(H11) Found the 1971 monument in good condition and at record bearing and distance from the 1971 witnesses. Marked two new bearing trees as described below.

(I11) Recovered the 1960 monument in good condition and at record bearing and distance from the 1960 accessories. The 24" W.Pine is now 30" DBH. The W.Pine stub is now rotting away with visible blaze and scribing detached from stump. Made 4 new witnesses as described below.

C. Description of monument for corner and accessories established to perpetuate locating the position of the corner:

(H11) Found 1" ID I.pipe with 4" alum. cap. Blazed, scribed, and set measuring nails in:


12" W.Pine S05W 9.9' "1/4S" 1971 wit.  
16" W.Pine N86E 43.6' do  
10" W.Pine S50E 7.05' "1/4S NBT"  
12" R.Pine N60W 38.05' do

Bearings are magnetic. Distances are to nail with tag.

(I11) Found 1" ID I.pipe with 4" brass MI Dept. of Conservation cap. Blazed, scribed, and set measuring nails in:

6" twin W.Pine S70W 49.4' "S34 NBT"  
8" J.Pine S84E 21.3' "S35 NBT"  
8" J.Pine S51E 21.4' "S35 NBT"  
6" J.Pine S34E 29.2' "S35 NBT"

Bearings are magnetic. Distances are to nail with tag.

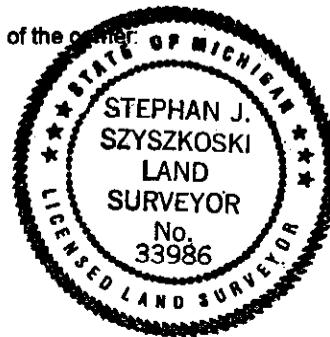

Signed by Stephan J. Szyszkoski  
Surveyor's Michigan License No. 33986

Date 8/25/03