

LAND CORNER RECORDATION CERTIFICATE
Filing Requirement of Act 74, Mich. P.A. 1970

For corners in

<u>Luca</u> (County)	Located In:	Corner Code #
1. Public Land Survey	T ___ R ___	_____
	T ___ R ___	_____
	T ___ R ___	_____
	T ___ R ___	_____
2. Property Controlling in Section	S <u>34</u> T <u>47N</u> R <u>11M</u>	<u>5</u>
	S <u>34</u> T <u>47N</u> R <u>11M</u>	<u>3</u>
3. Miscellaneous Property in Sec.	S ___ T ___ R ___	_____
	S ___ T ___ R ___	_____

Register of Deeds Stamp & File Number

4. Lot No. _____, Recorded Plat _____
5. Private Claims _____

3 Aug 06 2003
5 Aug 11 2003

I, Stephan J. Szyszkoski, in a field survey on _____, 20____ do hereby state that under requirements of P.A. 74, Michigan P.A. of 1970, the corner points mentioned in lines 1 and 2 above were in conformance with regulations and rules therefore as required in the current manual of survey instructions of the United States Department of the Interior, Bureau of Land Management or by a decree of a Court of Law and /or that the corner points mentioned in lines 3, 4 and 5 above were in conformance with the rules of the Michigan Board of Land Surveyors or by a Decree of a Court of Law; established, re-established, monumented, recovered, found as expressed below:

NOTE: Not more than 2 corners, all in the same town and range, may be recorded on this certificate.

	A	B	C	D	E	F	G	H	I	J	K	L	M
1													
2	6		5		4		3		2		1		
3													
4	7		8		9		10		11		12		
5													
6	18		17		16		15		14		13		
7													
8	19		20		21		22		23		24		
9													
10	30		29		28		27		26		25		
11													
12	31		32		33		34		35		36		
13													


A. Description of original monument and accessories and/or subsequent restoration:
(5-Sec. 34) North 1/16 corner Sec. 34. Established in 1978 by Billy D. Buckler RLS, midway and on line between H11 and H12.
(3-Sec. 34) North 1/16 corner between Sections 33-34. Not established in the original survey.

B. Description of corner evidence found and/or method applied in restoring or reestablishing corner:

(5-Sec. 34) The 1978 position for this corner was determined during a 1978 section subdivision that incorporated an erroneous location for I12. Consequently, the position monumented in 1978 is not correct. The 1978 monument was not recovered. I reestablished I12 and H12 and established this corner midway and on a straight line between H12 1328.33' south and H11 1328.33' north.
(3-Sec. 34) Established the corner midway and on a straight line between G12 1321.02' South and G11 1321.02' North.

C. Description of monument for corner and accessories established to perpetuate locating the position of the corner:

(5) Set 1"IDx36" I.pipe with plastic cap stamped "MICH DNR PS33986" flush with ground surface.	(3) Set 1"IDx36" I.pipe with 4" alum. MDNR cap. Blazed, scribed, and set measuring nails in:
Blazed, scribed and set meas. nails in:	
24" W.Pine N62W 40.9' "N1/16"	6" Spruce N22E 13.1' "N1/16 BT"
12" W.Pine N20E 26.65' "N1/16 BT"	6" W.Pine S23W 34.6' do
10" W.Pine S40E 34.85' do	14" W.Pine S53E 53.2' do
12" W.Pine S09E 32.1' do	6" Cherry N28W 33.8' do
Bearings are magnetic. Distances are to nail with tag.	Bearings are magnetic. Distances are to nail with tag.

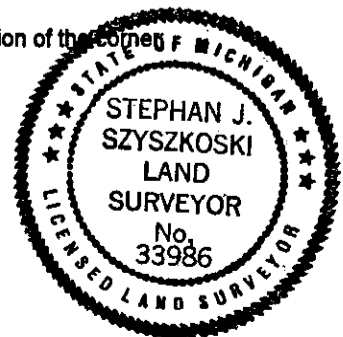

Signed by Stephan J. Szyszkoski
Surveyor's Michigan License No. 33986

Date 8/25/03