

LAND CORNER RECORDATION CERTIFICATE
Filing Requirement of Act 74, Mich. P.A. 1970

For corners in _____

Luca _____

(County)

Located in:

Corner Code # _____

1. Public Land Survey	T 47N R 11W	612
	T 47N R 11W	611
	T _____	_____
	T _____	_____
2. Property Controlling	S _____	_____
in Section	S _____	_____
3. Miscellaneous	S _____	_____
Property in Sec.	S _____	_____

4. Lot No. _____, Recorded Plat _____
 5. Private Claims _____

Aug 06 2003

I, Stephan J. Szyzkoski, in a field survey on _____, 20____ do hereby state that under requirements of P.A. 74, Michigan P.A. of 1970, the corner points mentioned in lines 1 and 2 above were in conformance with regulations and rules therefore as required in the current manual of survey instructions of the United States Department of the Interior, Bureau of Land Management or by a decree of a Court of Law and/or that the corner points mentioned in lines 3, 4 and 5 above were in conformance with the rules of the Michigan Board of Land Surveyors or by a Decree of a Court of Law, established, re-established, monumented, recovered, found as expressed below:

NOTE: Not more than 2 corners, all in the same town and range, may be recorded on this certificate.

A	B	C	D	E	F	G	H	I	J	K	L	M
1												
2	6	5	4	3	2	1						
3												
4	7	8	9	10	11	12						
5												
6	18	17	16	15	14	13						
7												
8	19	20	21	22	23	24						
9												
10	30	29	28	27	26	25						
11												
12	31	32	33	34	35	36						
13												

A. Description of original monument and accessories and/or subsequent restoration:
 (612) Quarter corner common to Sections 33-34, 1978; Reestablished midway and on line by Billy D. Buckler, RLS. Set 1" pipe with 4" aluminum cap. 20" N. Pine N85W 39.7', 16" N. Pine N07W 48.4'
 (611) Corner common to Sections 27-28-33-34. Reestablished in 1971 by Billy D. Buckler by proportionate measurement. Set 1" pipe with 4" aluminum cap. 36" N. Pine stump S47W 127.9'


B. Description of corner evidence found and/or method applied in restoring or reestablishing corner:

(612) Recovered the 1978 monument in good condition and at record bearing and distance from the 1978 witnesses, both in good condition. Made two new witnesses as described below.
 (611) Found the 1971 monument in good condition and N. Pine stump witness at record bearing and distance. Made new witnesses as described below.

C. Description of monument for corner and accessories established to perpetuate locating the position of the monument:

(612) Found 1" ID 1. pipe with 4" aluminum cap. Blazed, scribed and set measuring nails in:	(611) Found 1" ID 1. pipe with 4" alum. cap. Blazed, scribed, and set measuring nails in:
8" Spruce S36W 15.3' *1/4S N81"	5" Cherry S82E 29.0' *S34 N81"
8" Maple N87E 23.75' do	24" R. Pine N70E 95.3' *S23 N81"
30" W. Pine N85W 40.2' *1/4S 1978 N81	metal fence post S47E 0.25'
26" W. Pine N07W 48.55' do	36" W. Pine stump S53W 127.9' to face (no nail set). Bearings are magnetic.

Bearings are magnetic. Distances are to nail with tag. Set cedar post adjacent.
 Distances (unless noted) are to nail with tag.

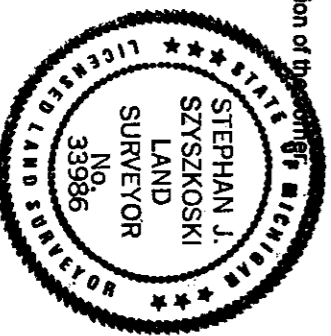

Signed by Stephan J. Szyzkoski
 Surveyor's Michigan License No. 33986

Date 8/25/03

Register of Deeds Stamp & File Number