

**LAND CORNER RECORDATION CERTIFICATE**  
**Filing Requirement of Act 74, Mich. P.A. 1970**

For corners in \_\_\_\_\_

Lucas

(County)

Located In: \_\_\_\_\_

Corner Code # \_\_\_\_\_

1. Public Land Survey T 47N R 11W H13
- T \_\_\_\_\_
- R \_\_\_\_\_
- T \_\_\_\_\_
- R \_\_\_\_\_
- T \_\_\_\_\_
- R \_\_\_\_\_
2. Property Controlling S \_\_\_\_\_
- S \_\_\_\_\_
- T \_\_\_\_\_
- R \_\_\_\_\_
- S \_\_\_\_\_
- T \_\_\_\_\_
- R \_\_\_\_\_
3. Miscellaneous S \_\_\_\_\_
- S \_\_\_\_\_
- T \_\_\_\_\_
- R \_\_\_\_\_

4. Lot No. \_\_\_\_\_, Recorded Plat \_\_\_\_\_
5. Private Claims \_\_\_\_\_

Sep 17 2002

1. Stephan J. Szyzkowski in a field survey on 20 do hereby state that under requirements of P.A. 74, Michigan P.A. of 1970, the corner points mentioned in lines 1 and 2 above were in conformance with regulations and rules therefore as required in the current manual of survey/instructions of the United States Department of the Interior, Bureau of Land Management or by a decree of a Court of Law and/or that the corner points mentioned in lines 3, 4 and 5 above were in conformance with the rules of the Michigan Board of Land Surveyors or by a Decree of a Court of Law, established, re-established, monumented, recovered, found as expressed below:

NOTE: Not more than 2 corners, all in the same town and range, may be recorded on this certificate.

	A	B	C	D	E	F	G	H	I	J	K	L	M
1													
2	6	5	4	4	3	2	1						
3													
4	7	8	9	9	10	11	12						
5													
6	18	17	16	15	14	13							
7													
8	19	20	21	22	23	24							
9													
10	30	29	28	27	26	25							
11													
12	31	32	33	34	35	36							
13													

A. Description of original monument and accessories and/or subsequent restoration:  
 (H13) Quarter corner common to Sections 34 147N-11W and 3 146N-11W, 1841-established by John Burt for Wm. A. Burt: West on South side of Section 34...40.00 Set qr. section post. Maple 10 N45E 31, Birch 24 N7W 29...80.00 Set post corner of Sections 33 and 34, 1978- Reestablished by Billy D. Buckler RLS midway an on line between Section corner east and west. At the corner, Mr. Buckler set a 1" pipe with 4" aluminum cap. 14" Hemlock S69W 8.9', 12" H.Maple S77E 16.8', 12" S.Maple SSE 33.5'.


B. Description of corner evidence found and/or method applied in restoring or reestablishing corner:

(H13) The original post and accessories were not recovered. Found the 1978 monument in good condition and at record bearing and distance from the NBT accessories: the Maples in good condition, the Hemlock a cut stump. I did not accept this monument as marking the corner position. The Section corner 1/2 mile east, relied upon in 1978 to reestablish this corner, was monumented in 1960 using improper procedures. I reestablished the Section corner at the proper position in this survey and I reestablished H13 midway and on a line of mean true bearing between Section corners 2446.53' east and west. The 1978 monument seems not to have been relied upon but by the Michigan Dept. of Natural Resources, on whose behalf I reestablished this corner. Reinstalled the 1978 monument at the proper position, being 11.16' northerly from the 1978 position.

C. Description of monument for corner and accessories established to perpetuate locating the position of the corner:

- (H13) Set 1" IDx36" I. pipe with 4" dia. alum. State of Michigan cap. Blazed, scribed, and set measuring nails in:
- 14" Maple South 21.5' \* 1/4S \*
  - 20" Maple S46W 44.9' do \*
  - 14" Y. Birch N74E 31.15' \* 1/4S NBT \*
  - 10" Maple S72W 9.75' do
- Old wood post adjacent. Bearings are magnetic. Distances are to nail with tag. \* denotes 1978 witness tree.

Signed by Stephan J. Szyzkowski  
 Surveyor's Michigan License No. 33986

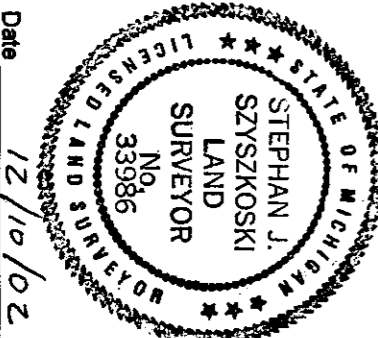

Date 12/10/02

Register of Deeds Stamp & File Number