


LAND CORNER RECORDATION CERTIFICATE
Filing Requirement of Act 74, Mich. P.A. 1970 as Amended

For corners in

<u>Luce</u> (County)	Located In:	Corner Code #
1. Public Land Survey	T <u>46N</u> R <u>12W</u>	<u>61</u>
	T <u>47N</u> R <u>12W</u>	<u>613 (same corner)</u>
	T _____ R _____	_____
2. Property Controlling in Section	S _____ T _____ R _____	_____
	S _____ T _____ R _____	_____
3. Miscellaneous Property in Sec.	S _____ T _____ R _____	_____
	S _____ T _____ R _____	_____
4. Lot No. _____, Recorded Plat _____		
5. Private Claims		

Register of Deeds Stamp & File Number

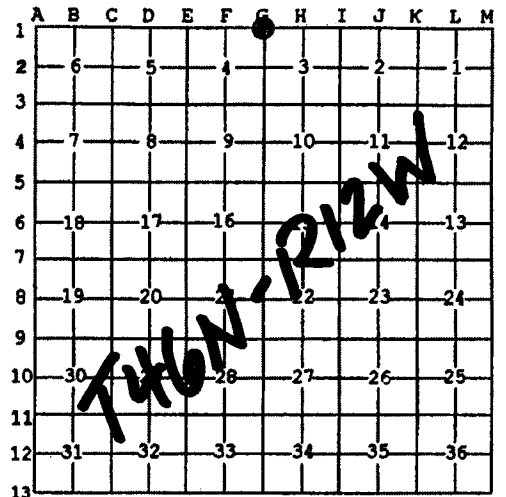

Oct 02 2006

I, Stephan J. Szyszkoski, in a field survey on _____, 20____ do hereby state that under requirements of P.A. 74, Michigan P.A. of 1970, the corner points mentioned in lines 1 and 2 above were in conformance with regulations and rules therefore as required in the current manual of survey instructions of the United States Department of the Interior, Bureau of Land Management or by a decree of a Court of Law and /or that the corner points mentioned in lines 3, 4 and 5 above were in conformance with the rules of the Michigan Board of Land Surveyors or by a Decree of a Court of Law; established, re-established, monumented, recovered, found as expressed below:

NOTE: Not more than 2 corners, all in the same town and range, may be recorded on this certificate.

A. Description of original monument and accessories and/or subsequent restoration:

(G1) Corner common to Sections 3-4 T46N-R12W and Sections 33-34 T47N-R12W. 1841 - Established by Wm. Burt, Deputy Surveyor: West on south side Sec. 34 ...80.00 Set post corner Secs. 33 & 34 in stream 60L C S. Fir 10 N60E 70 links, Spruce 15 N75W 40 links. 1851 - Francis Colman, Deputy Surveyor: N15W corrected between Sections 33 & 34...0.06 Leave Stream 70 SE, 1.45 Stream 10 SSW, 2.45 Over Stream rapid and shallow. 1851 - Francis Colman, S03'E corrected between secs 3 & 4. Cedar 12 S14E 28 links, Cedar 12 S29W 24 links. Post being in River. C of River SSE. Found no subsequent record.

B. Description of corner evidence found and/or method applied in restoring or reestablishing corner:

(G1) The original post and accessories were not recovered. The original bearing trees were probably washed out by the meandering Tahquamenon River long ago. Found no acceptable evidence of the position of the original corner on the ground. Reestablished the corner by single proportionate measurement to the original record between 1/4 corner 2637.41' west (2640' R) and Section corner 5274.82' east (5280' R). From the position thus established, the SE'ly edge of the River crosses the Section line 43' north and crosses the township line 48' west. I found a 2" iron pipe, not of record, N12W 18.3' and a 1.5" iron pipe, not of record, S52E 33.7' distant. Interviews of adjacent landowners Mr. Clark and Mr. Edstrom revealed that neither knows the origin of either pipe and neither claims that either one represents the position of the corner. I did not accept either of these pipes as reliable evidence of the position of the original corner. I note that a number of other corners on Section 4 seem to have been monumented at approximate positions by unknown persons.

C. Description of monument for corner and accessories established to perpetuate locating the position of the corner:

(G1) Set 1"IDx36" I.pipe with 4" alum.
 MDNR Cap. Set measuring nails in:
 13" R.Pine S29W 17.88' mrkd "S4 NBT"
 15" W.Pine N79W 32.76' "S33 NBT"
 26" R.Pine N03E 15.98' "S34 NBT"
 7" Spruce S72E 6.16' "S3 NBT"
 Bearings are magnetic. Distances are to nail with MDNR tag.



Signed by Stephan J. Szyszkoski
 Surveyor's Michigan License No. 33986

Date 12/13/06