

# LAND CORNER RECORDATION CERTIFICATE

**FILING REQUIREMENT OF ACT 74, MICH. P.A.1970**

Luce Co.

Two Corners.

FOR CORNERS OF--:	LOCATED IN--:	CORNER CODE NUMBER
1. PUBLIC LAND SURVEY _____	T. <u>48</u> N. <u>X.</u> R. <u>8</u> W.	E-12 F-11
2. PROPERTY CONTROLLING IN SECTION _____	, T. _____ N. _____ S. _____ R. _____ E. _____ W. _____	_____
3. MISCELLANEOUS PROPERTY IN SECTION _____	, T. _____ N. _____ S. _____ R. _____ E. _____ W. _____	_____
4. LOT NO. _____, RECORDED PLAT _____		
5. PRIVATE CLAIMS _____		

REGISTER OF DEEDS STAMP AND FILING NUMBER

I, Billy D. Buckler do hereby certify that under requirements of P.A. 74, Michigan P.A. of 1970, the corner points mentioned in lines 1 and 2 above (identified with circles on index code diagram - over) were, in a field survey on 1-17 1975, established, re-established, monumented, re-monumented, recovered or restored as expressed below and in conformance with regulations and rules therefore as required in the current manual of survey instructions of the United States Department of the Interior, Bureau of Land Management or by a decree of a court of law. Furthermore, that the corner points mentioned in lines 3, 4 and 5 above were, in a field survey on \_\_\_\_\_ 19\_\_\_\_, found, recovered, restored, established or re-established as expressed below and in conformance with the rules of the Michigan State Board of Registration for Land Surveyors or, by a Decree of a Court of law:

**A. Description of original monument and accessories and/or subsequent restoration:**

Both corners set by Wells Burt, D.S. in 1850.  
 E-12 Quarter Corner bet. Sec's. 32-33.  
 Bearings were: Maple 8, S50°W, 23 lks. and Fir 12, N82°E, 27 lks.  
 F-11 Quarter Corner bet. Sec's. 28-33.  
 Bearings were: W. Pine 48, S88°W, 11 lks. and Maple 12, N75°E, 7 lks.


**B. Description of corner evidence found and/or method applied in restoring or re-establishing corner:**

E-12 Corner re-established midway and on line bet. two original Section corners.  
 Found no evidence of original corner.  
 F-11 Corner replaced from the W. Pine witness, S88°W, 11 lks; stump in good condition.

**C. Description of monument for corner and accessories established to perpetuate locating the position of the corner:**

Placed 1" pipe with 4" aluminium cap at both corners.  
 E-12 New Bearings: 10" Cedar, N62°W, 25.0' and 6" Cedar, N3°E, 31.5' 25' North of  
 F-11 New Bearings: 8" Cedar, N13°W, 26.6' and 10" Cedar, N87°E, 23.9' Charcoal grade

SIGNED BY Billy D. Buckler DATE 4-7-75

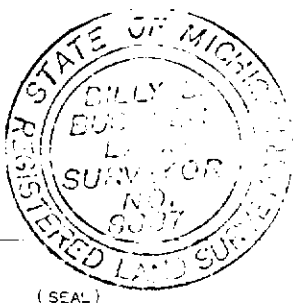

SURVEYOR'S MICHIGAN REGISTRATION NO. 8887

**FOR STATE AND UNITED STATES AGENCIES:**

SIGNED BY \_\_\_\_\_ DATE \_\_\_\_\_  
CHIEF OF SURVEY PARTY

APPROVED AND SIGNED BY \_\_\_\_\_ DATE \_\_\_\_\_  
MICHIGAN REGISTERED LAND SURVEYOR

SURVEYOR'S MICHIGAN REGISTRATION NO. \_\_\_\_\_