

LAND CORNER RECORDATION CERTIFICATE

FILING REQUIREMENT OF ACT 74, MICH. P.A. 1970
 Luce Co. 1 Corner

| FOR CORNERS OF--: | LOCATED IN--: | CORNER CODE NUMBER |
|--|--|--------------------|
| 1. PUBLIC LAND SURVEY _____ | T. <u>48</u> ^{N.} S. , R. <u>8</u> ^{E.} W. | <u>C-12</u> |
| 2. PROPERTY CONTROLLING IN SECTION _____ | T. _____, S., R. _____, E. _____, W. _____ | _____ |
| 3. MISCELLANEOUS PROPERTY IN SECTION _____ | T. _____, S., R. _____, E. _____, W. _____ | _____ |
| 4. LOT NO. _____, RECORDED PLAT _____ | | |
| 5. PRIVATE CLAIMS _____ | | |

REGISTER OF DEEDS STAMP AND FILING NUMBER

I, Billy D. Buckler, do hereby certify that under requirements of P.A. 74, Michigan P.A. of 1970, the corner points mentioned in lines 1 and 2 above were, in a field survey on 7-16, 1973, established, re-established, monumented, re-monumented, recovered or restored as expressed below and in conformance with regulations and rules therefore as required in the current manual of survey instructions of the United States Department of the Interior, Bureau of Land Management or by a decree of a court of law. Furthermore, that the corner points mentioned in lines 3, 4 and 5 above were, in a field survey on _____, 19____, found, recovered, restored, established or re-established as expressed below and in conformance with the rules of the Michigan State Board of Registration for Land Surveyors or, by a Decree of a Court of law:


A. Description of original monument and accessories and/or subsequent restoration:
C-12 Quarter Corner bet. Sec's 31-32, set by Wells Burt, D.S. in 1850.
 Bearings were: Hemlock 20", N60°W, 11 lks. and Cedar 16", S75°E, 10 lks.

B. Description of corner evidence found and/or method applied in restoring or re-establishing corner:
C-12 Replaced corner at a wood post, which I believe was set by H. C. Lawrence, R.L.S. before 1945. Position checks with section corner, 1/2 mile North.

C. Description of monument for corner and accessories established to perpetuate locating the position of the corner:
C-12 Placed 1" pipe with 4" aluminium cap at corner.
 New Bearings: 9" Cedar, S82°W, 28.7' and 13" Cedar, N68°E, 21.5'.

SIGNED BY Billy D. Buckler DATE 1-9-79

SURVEYOR'S MICHIGAN REGISTRATION NO. 8887

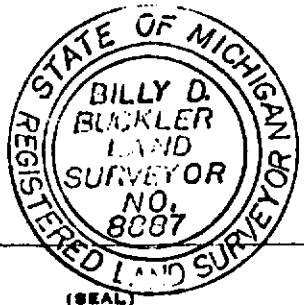

FOR STATE AND UNITED STATES AGENCIES:
 SIGNED BY _____ DATE _____
CHIEF OF SURVEY PARTY
 APPROVED AND SIGNED BY _____ DATE _____
MICHIGAN REGISTERED LAND SURVEYOR

SURVEYOR'S MICHIGAN REGISTRATION NO. _____