

MICHIGAN
DEPARTMENT OF CONSERVATION
FORESTRY DIVISION

LAND CORNER RECORD

T. 48 N. R. 8-9 W


Luce COUNTY

DESCRIPTION OF CORNER Sec. Cor. common to Secs. 1-12-6-7.

CORNER MONUMENT 1" Pipe with 4" Aluminum Cap.

DATE MONUMENT PLACED AND WITNESSED 3/12/68

WITNESSES TO CORNER..... 24" W. Pine (S 7 NBT) S 51°E 54.6'

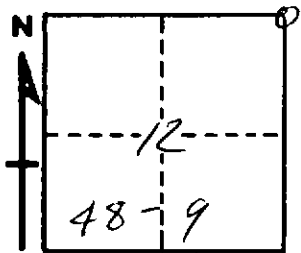

18" Hemlock (S 12 NBT) S47°W 21.0'

5" Cedar (S 1 NBT) N54°W 32.4'

AND

CIRCLE CORNER REGISTERED

DESCRIPTION IN DETAIL AS TO HOW CORNER WAS LOCATED AND IDENTIFIED OR RESTORED.

This corner replaced from one B.T., a dead, yellow birch, bearing N21°E 36 links. Found face and scribe marks in excellent condition. Corner found by L. Rubick, Forestry Aide, while running section lines in this township.

SURVEYOR'S SEAL

SIGNED Billy D. Buckler
Billy D. Buckler
REGISTERED LAND SURVEYOR

DATE 6/28/68