

MICHIGAN  
DEPARTMENT OF CONSERVATION  
FORESTRY DIVISION

# LAND CORNER RECORD

T. 48 N. R. 9W


Luce COUNTY

DESCRIPTION OF CORNER Sec. Cor. 3-4-9-10

CORNER MONUMENT 1" Pipe with 4" aluminum cap.

DATE MONUMENT PLACED AND WITNESSED 2/29/68

WITNESSES TO CORNER..... 9" W. Pine (S4 NBT) N39°W 60.3'

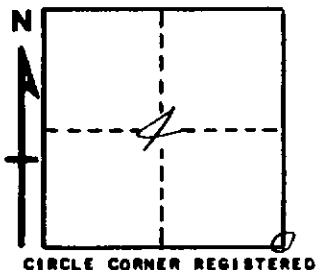

14" W. Pine (S9 NBT) S87°W 53.4'

AND

**DESCRIPTION IN DETAIL AS TO HOW CORNER WAS LOCATED AND IDENTIFIED OR RESTORED.**

This corner replaced asset by H. Lawrence, R. L. S.  
Found wood post in place with one Tamarack bearing  
tree, S. W. of corner. This is an 8' stub in ex-  
cellent condition. Corner found by L. Kubick,  
Forestry Aide.

Corner lies in open marsh, 40' S. E. of a pine ridge.

**SURVEYOR'S SEAL**

*Billy D. Buckler*  
SIGNED Billy D. Buckler DATE 6/28/68  
REGISTERED LAND SURVEYOR