

MICHIGAN
DEPARTMENT OF CONSERVATION
FORESTRY DIVISION

LAND CORNER RECORD

T. 48 N. R. 9


Luce COUNTY

DESCRIPTION OF CORNER Sec. Cor. 1-2-11-12

CORNER MONUMENT 1" pipe with 4" aluminum cap.

DATE MONUMENT PLACED AND WITNESSED 2/29/68

WITNESSES TO CORNER..... 6" Cedar (S12 NBT) S68°E 17.0'

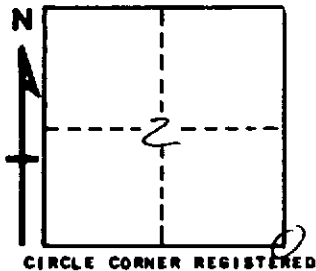

10" W. Pine (S2 NBT) N30°W 2.5'

AND

DESCRIPTION IN DETAIL AS TO HOW CORNER WAS LOCATED AND IDENTIFIED OR RESTORED.

This corner replaced as set by C.C.I. surveyor. Found a wood post in place with remains of a 30" W. Pine stump, bearing N45°W, 10 links. Found several old blazed at corner. Found brushed lines N, E and W. from corner.

SURVEYOR'S SEAL

SIGNED Billy D. Buckler DATE 6/23/68
REGISTERED LAND SURVEYOR