

STATE OF MICHIGAN
DEPARTMENT
OF
NATURAL RESOURCES


LAND CORNER RECORD

Luce COUNTY
T 48N R 9W

DESCRIPTION OF CORNER Meander corner bet. Secs. 2-11 on east edge of main lake
CORNER MONUMENT of the Little Two Hearted Lakes.
1" pipe with 4" aluminum cap.

DATE MONUMENT PLACED AND WITNESSED 7-16-68

WITNESSES TO CORNER..... 6" cedar (MC NBT) S9°W 10.9'

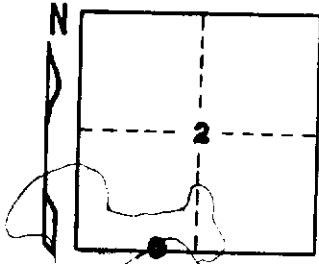

9" Tamarack (MC NBT) N55°E 23.7'

AND

CIRCLE CORNER REGISTERED

DESCRIPTION IN DETAIL AS TO HOW CORNER WAS LOCATED AND IDENTIFIED OR RESTORED.

This meander corner placed on line bet. corners to east and west and at 54.40 chs. from
Sec. Cor. to east.

SURVEYOR'S SEAL

DISTRIBUTION:

SIGNED

Billy D. Buckler
Billy D. Buckler
REGISTERED LAND SURVEYOR

DATE

3-27-69

County Courthouse
Area Forester (Regions I & II)
District or Region Surveyor
Forestry Div., Lansing