

STATE OF MICHIGAN  
DEPARTMENT  
OF  
NATURAL RESOURCES

LAND CORNER RECORD


Luce COUNTY  
T 48N R 9W

DESCRIPTION OF CORNER Meander cor. bet. Secs. 2-11, on east shore of the Little Two Hearted Lakes.

CORNER MONUMENT 1" pipe with 4" aluminum cap.

DATE MONUMENT PLACED AND WITNESSED 7-16-68

WITNESSES TO CORNER..... 8" cedar (MC NBT) S34°E 10.4'

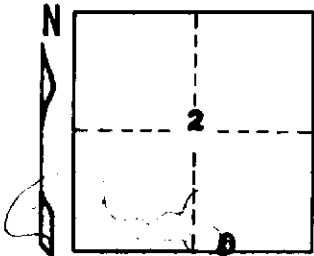

7" cedar (MC NBT) N88°E 7.4'

AND

CIRCLE CORNER REGISTERED

DESCRIPTION IN DETAIL AS TO HOW CORNER WAS LOCATED AND IDENTIFIED OR RESTORED.

This meander cor. re-established on line bet. corners to east and west.  
Found old blazes on line but no evidence of witnesses at corner.  
Corner set at 33.75 chs. from Sec. Cor. to east.

SURVEYOR'S SEAL

SIGNED

Billy D. Buckler  
REGISTERED LAND SURVEYOR

DATE

3-27-69

DISTRIBUTION:

County Courthouse  
Area Forester (Regions I & II)  
District or Region Surveyor  
Forestry Div., Lansing