

MICHIGAN  
DEPARTMENT OF CONSERVATION  
FORESTRY DIVISION

# LAND CORNER RECORD

T. 48-49 N. R. 9W


Luce COUNTY

DESCRIPTION OF CORNER Section Corner common to Secs. 3-4-33-34

CORNER MONUMENT 1" pipe with 4" aluminum cap.

DATE MONUMENT PLACED AND WITNESSED 7/12/68

WITNESSES TO CORNER..... 12" Red Pine (S33 NBT) N17°W 41.5'

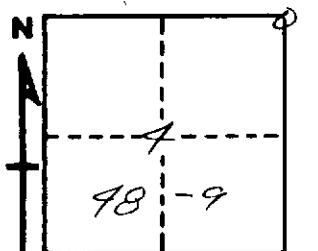

8" Red Pine (S34 NBT) N37°E 33.1'

AND

CIRCLE CORNER REGISTERED

DESCRIPTION IN DETAIL AS TO HOW CORNER WAS LOCATED AND IDENTIFIED OR RESTORED.

This corner re-established along township line by single proportionate measure to corners East and West.  
Found very old blazes on pine stubs along this line.

SURVEYOR'S SEAL

*Billy D. Buckler*  
SIGNED Billy D. Buckler, R.L.S. DATE 9/13/68  
REGISTERED LAND SURVEYOR