

LAND CORNER RECORDATION CERTIFICATE

FILING REQUIREMENT OF ACT 74, MICH. P.A.1970

Luce Co.

Three Corners.

FOR CORNERS OF--	LOCATED IN--	CORNER CODE NUMBER
1. PUBLIC LAND SURVEY	T. 48 ^{N.} S. , R. 11 ^{E.} W.	F-5, G-7
2. PROPERTY CONTROLLING IN SECTION 16	T. 48 ^{N.} S. , R. 11 ^{E.} W.	6, Sec. 16
3. MISCELLANEOUS PROPERTY IN SECTION	T. _____ ^{N.} S. , R. _____ ^{E.} W.	
4. LOT NO. _____, RECORDED PLAT _____		
5. PRIVATE CLAIMS _____		

REGISTER OF DEEDS STAMP AND FILING NUMBER


I, Billy D. Buckler do hereby certify that under requirements of P.A. 74, Michigan P.A. of 1970, the corner points mentioned in lines 1 and 2 above (identified with circles on index code diagram—over) were, in a field survey on 8/5 1974, established, re-established, monumented, re-monumented, recovered or restored as expressed below and in conformance with regulations and rules therefore as required in the current manual of survey instructions of the United States Department of the Interior, Bureau of Land Management or by a decree of a court of law. Furthermore, that the corner points mentioned in lines 3, 4 and 5 above were, in a field survey on _____ 19____, found, recovered, restored, established or re-established as expressed below and in conformance with the rules of the Michigan State Board of Registration for Land Surveyors or, by a Decree of a Court of law:

A. Description of original monument and accessories and/or subsequent restoration:
 Corners placed by Geo. H. Cannon D.S. in 1853 during a correctional survey.
 F-5 $\frac{1}{4}$ Cor. bet. Sec's, 9-16. Bearings were: A Cedar 18" for corner tree and a Balsam 10", N68°W, 25 lks.
 G-7 Sec. Cor. 15-16-21-22. Bearings were: Hemlock 12", S12°W, 21 lks. and Hemlock 14", N19 E, 23 lks.
 6, Sec. 16 Northeast 1/16 Cor. Sec, 16.

B. Description of corner evidence found and/or method applied in restoring or re-establishing corner:
 F-5 Corner replaced in an 18" Cedar stump, believed to be the original corner tree. Position checks with stream, bank and a line tree to East.
 G-7 Corner replaced from two Hemlock stump bottoms in proper position. Found a Y. Birch line tree to West of corner, also old blazed line to West and South.
 6, Sec. 16 Corner placed at intersection of lines, quartering the Northeast quarter sec.

C. Description of monument for corner and accessories established to perpetuate locating the position of the corner:
 Placed 1" pipe with 4" aluminium cap at all corners.
 F-5 New Bearings: 13" Cedar, S74°W, 27.6' and 13" Cedar, N64°W, 30.7'
 G-7 New Bearings: 12" Soft Maple, N22°E, 21.6' and 14" Soft Maple, S71°W, 18.6'
 6, Sec. 16 Bearings: 13" Cedar, N28°W, 1.2' and 13" Cedar, S52°E, 24.2'

SIGNED BY Billy D. Buckler DATE 8/22/74
 SURVEYOR'S MICHIGAN REGISTRATION NO. 8887

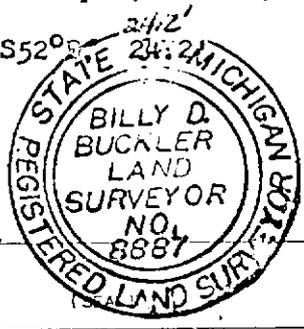

FOR STATE AND UNITED STATES AGENCIES:
 SIGNED BY _____ DATE _____
CHIEF OF SURVEY PARTY
 APPROVED AND SIGNED BY _____ DATE _____
MICHIGAN REGISTERED LAND SURVEYOR (SEAL)