


SEC. 30, T79N R. 0. W.

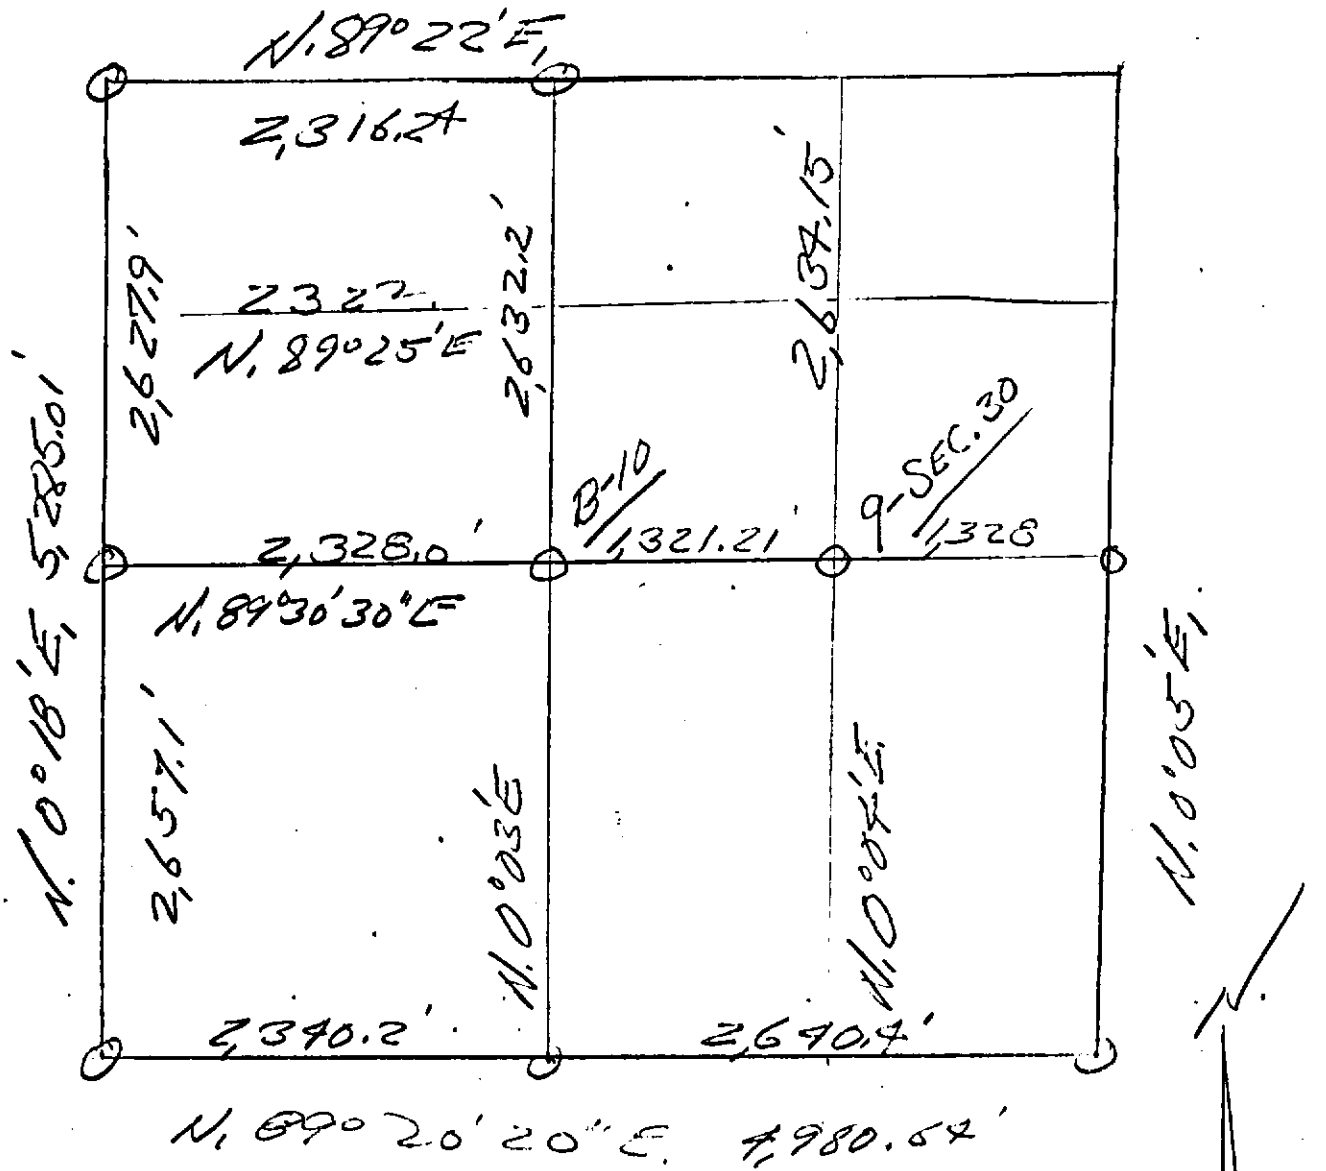

No. SCALE:

4-10-78
RDB