


SEC. 7, T. 49 N. R. 8 W., LUCE CO.
Sub-division

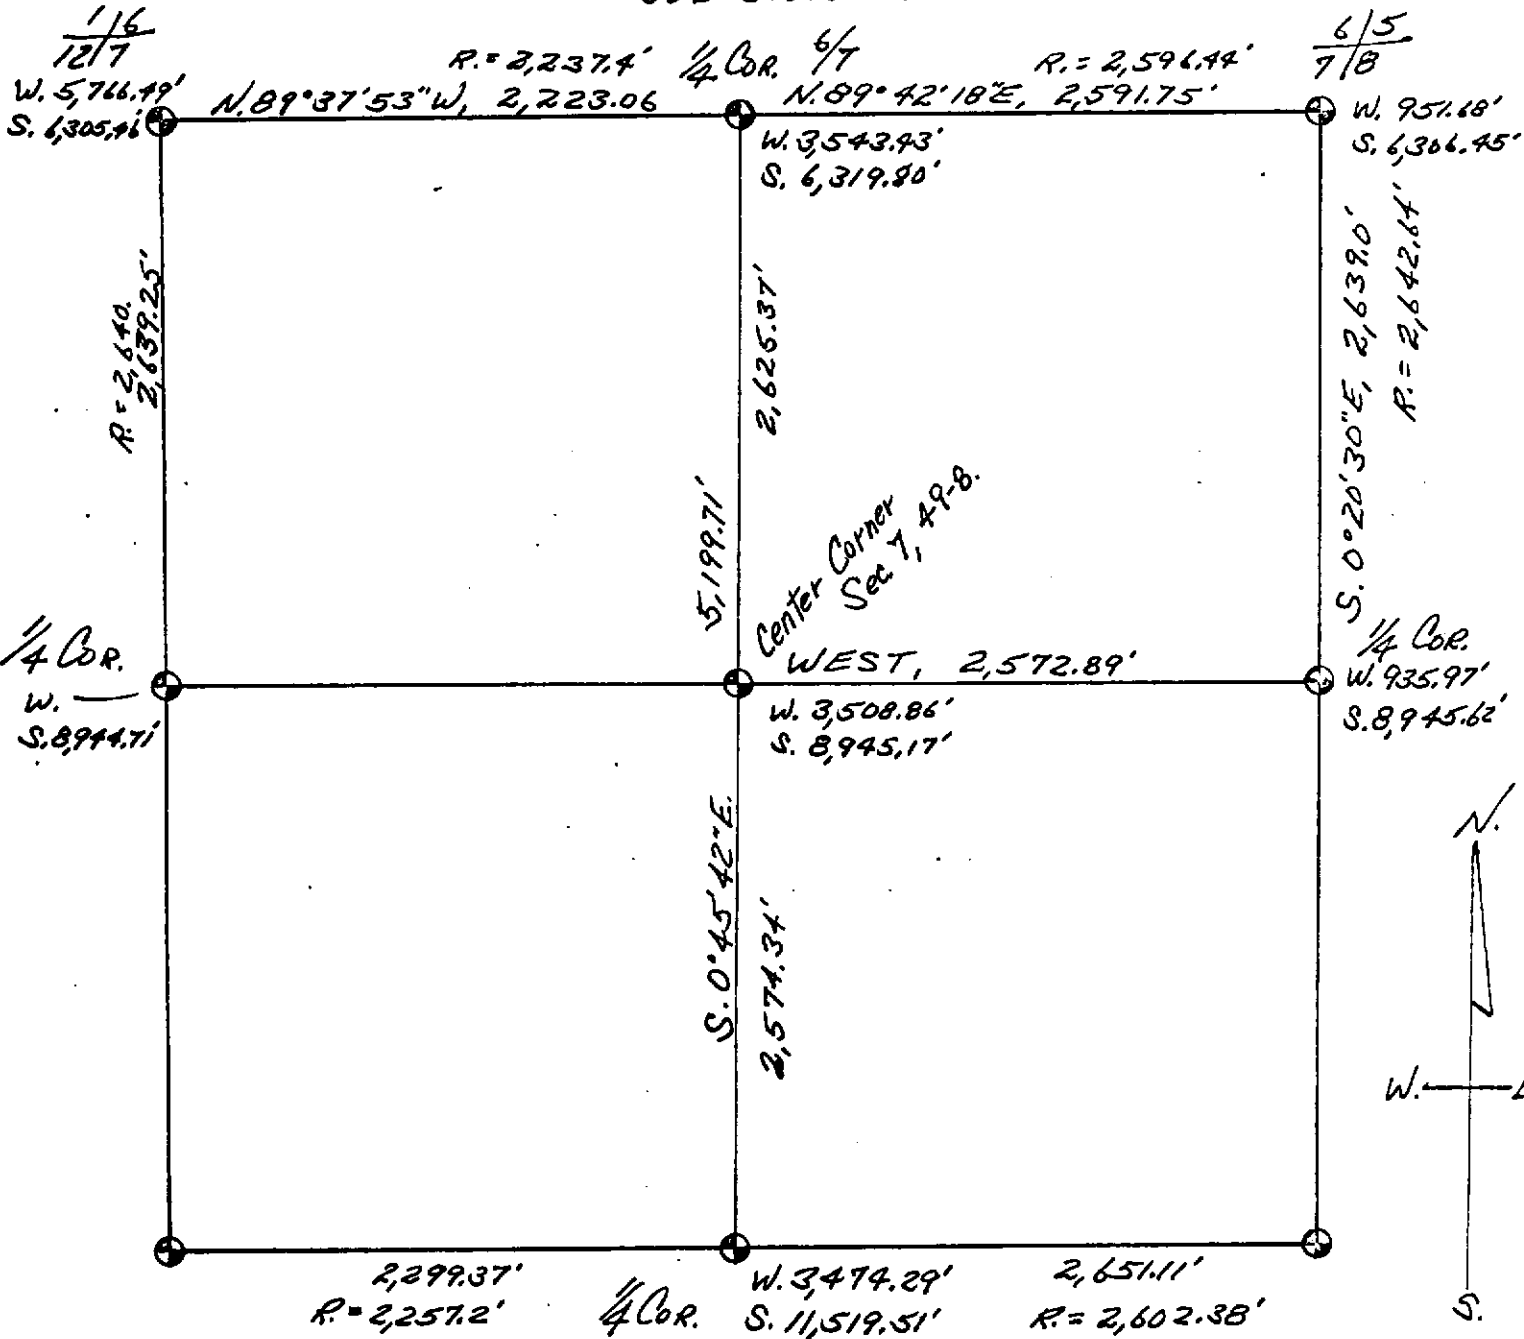

--- Dept. Marker placed.

Billy D. Buckler, R.L.S.