LAND CORNER RECORDATION CERTIFICATE

Filing Requirement of Act 74, Mich. P.A. 1970

For corners in

LUCE (County)

3 Corners Located In:

			Corner Code
1 Public Land Survey		T 49N R 8W	A-5
		T 49N R 8W	A-7
		T ___ R ___	
		T ___ R ___	
2 Property Controlling	S 18	T 49N R 8W	15
in Section	S ___	T ___ R ___	
3. Miscellaneous	S ___	T ___ R ___	
Property in Sec.	S ___	T ___ R ___	

Register of Deeds Stamp & File Number

4 Lot No. ___ Recorded Plat ___

5 Private Claims ___

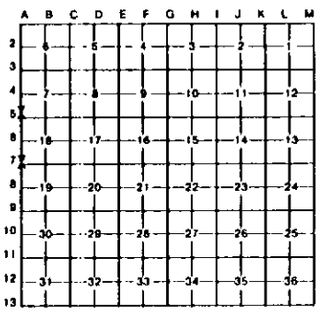

I, Gerald L. Wiggins, in a field survey on 5-8 & 6-26, 1990, do hereby certify that under requirements of P.A. 74, Michigan P.A. of 1970, the corner points mentioned in lines 1 and 2 above were in conformance with regulations and rules therefore as required in the current manual of survey instructions of the United States Department of the Interior, Bureau of Land Management or by a decree of a Court of Law and/or that the corner points mentioned in lines 3, 4 and 5 above were in conformance with the rules of the Michigan Board of Land Surveyors or by a Decree of a Court of Law; established, re-established, monumented, re-monumented, recovered, found as expressed below:

NOTE: Not more than 4 corners, all in the same town and range, may be recorded on this certificate.

A. Description of original monument and accessories and/or subsequent restoration:

A-5 N.W. Section Corner of Section 18. Placed by Billy D. Buckler R.L.S. on 5-8-52. Bearings: 10" Red Oak, N85°E, 54.12' & 10" Red Oak, N36°W, 29.7'.

A-7 S.W. Section Corner of Section 18. Placed by Billy D. Buckler R.L.S. on 5-8-52. Bearings: 8" R. Pine, S73°E. 12.54' & 12" R. Pine, S60°W, 23.76'.

15 West 1/16 Corner on south side of Section 18. Not previously set.

B. Description of corner evidence found and/or method applied in restoring or reestablishing corner:

A-5 Buckler's witness trees still green and standing and monument still in place. Placed new squared post at corner and marked two new witness trees.

A-7 Both of Buckler's Red Pine Witness Trees had been cut. Marked four new witness trees. Monument still in place.

15 Corner set M.P.O.L. between S.W. Corner and South 1/4 Corner of Section 18.

C. Description of monument for corner and accessories established to perpetuate locating the position of the corner:

A-5 DNR Monument. Buckler's two Red Oaks still in place. Marked a 14" Twin Red Pine, N50°W, 59.4' & 12" Twin Red Pine, S80°E, 26.25'.

A-7 DNR Monument. 14" W. Pine, S20°W. 29.1' & 12" W. Pine, N65°W, 36.7' & 12" W. Pine, N16°W, 36.0' & 14" W. Pine, N40°E, 32.2'.

15 DNR Monument. 12" R. Pine, S86°W, 16.7' & 12" R. Pine, N25°W. 16.5' & 12" R. Pine, N38°E, 6.1' & 8" R. Pine, N80°E, 5.25'.

Signed by Gerald L. Wiggins Date 9-13-90

Surveyor's Michigan License No. 23521

STATE OF MICHIGAN GERALD L. WIGGINS LAND SURVEYOR No. REGISTERED LAND SURVEYOR

FORM APPROVED BY THE MICHIGAN STATE BOARD OF LAND SURVEYORS, JAN. 28, 1971 REVISED MAY 14, 1976 REVISED JAN., 1983