

LAND CORNER RECORDATION CERTIFICATE

FILING REQUIREMENT OF ACT 74, MICH. P.A.1970

Luce Co.

6 Corners.

FOR CORNERS OF--	LOCATED IN--	CORNER CODE NUMBER
1. PUBLIC LAND SURVEY	T. <u>49</u> ^{N.} K. , R. <u>9</u> ^{K.} W.	J-2, J-3 11-Sec.2, 12-Sec.2
2. PROPERTY CONTROLLING IN SECTION	<u>2</u> , T. <u>49</u> ^{N.} X. , R. <u>9</u> ^{K.} W.	<u>13-Sec.2</u> <u>14-Sec.2</u>
3. MISCELLANEOUS PROPERTY IN SECTION	, T. _____, R. _____ ^{N.} S. , ^{E.} W.	
4. LOT NO. _____, RECORDED PLAT _____		
5. PRIVATE CLAIMS _____		

REGISTER OF DEEDS STAMP AND FILING NUMBER

I, Billy D. Buckler, do hereby certify that under requirements of P.A. 74, Michigan P.A. of 1970, the corner points mentioned in lines 1 and 2 above were, in a field survey on 3-15 & 7-2, 19 76, established, re-established, monumented, re-monumented, recovered or restored as expressed below and in conformance with regulations and rules therefore as required in the current manual of survey instructions of the United States Department of the Interior, Bureau of Land Management or by a decree of a court of law. Furthermore, that the corner points mentioned in lines 3, 4 and 5 above were, in a field survey on _____, 19____, found, recovered, restored, established or re-established as expressed below and in conformance with the rules of the Michigan State Board of Registration for Land Surveyors or, by a Decree of a Court of law:

A. Description of original monument and accessories and/or subsequent restoration:

- J-2 Center Corner of Section 2, T49N R9W.
- 11-Sec.2 South-West 1/16 Corner of Section 2.
- 12-Sec.2 South 1/16 Corner of Section 2.
- J-3 South 1/4 Corner of Section 2, set by Harvey Mellen, D.S. in 1850.
Bearings were: Spr. Pine, 12", N16°E, 09 lks & Spr. Pine 10", S1°W, 43 lks.
- 13-Sec.2 South-East 1/16 Corner of Section 2, T49N R9W
- 14-Sec.2 South 1/16 Corner on eastside of Section 2.


B. Description of corner evidence found and/or method applied in restoring or re-establishing corner:

- J-2 Corner placed at intersection lines connecting opposite quarter corners.
- 11-Sec.2 Corner placed at intersection of lines, quartering the South-West quarter section.
- 12-Sec.2 Corner placed midway bet. 1/4 Cor. to South and Center corner to North.
- J-3 Corner re-established midway and on line bet. two section corners. Found no evidence of original corner.
- 13-Sec.2 Corner placed at intersection of lines quartering the South-East quarter section.
- 14-Sec.2 Corner placed midway between 1/4 corner to North and section corner to South.

C. Description of monument for corner and accessories established to perpetuate locating the position of the corner:

- Placed 1" pipe with 4" aluminium cap at all corners except 14-Sec.2.
- J-2 Bearings: 6" Jack Pine, N86°E, 18.8' and 6" Jack Pine, S16°E, 12.8'.
- 11-Sec.2 Bearings: 6" Jack Pine, East, 28.0' and 8" Jack Pine, West, 13.5'.
- 12-Sec.2 Bearings: 14" Red Pine, N37°W, 41.5' and 6" Jack Pine, S47°W, 16.8'.
- J-3 New Bearings: 8" W. Pine, N38°E, 29.8' and 8" Jack Pine, N47°W, 19.8'.
- 13-Sec.2 Bearings: 8" R. Pine, S18°E, 15.7' and 12" Red Pine, N47°W, 33.8'
- 14-Sec.2 1" x 36" Iron Pipe buried in East rut of North-South road.
Bearings: 12" Red Pine, N87°E, 19.6' and 12" Red Pine, N46°W, 35.1'.

SIGNED BY Billy D. Buckler DATE 2-27-77
 Billy D. Buckler
 SURVEYOR'S MICHIGAN REGISTRATION NO. 8887

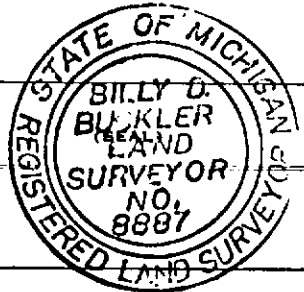

FOR STATE AND UNITED STATES AGENCIES:

SIGNED BY _____ DATE _____
CHIEF OF SURVEY PARTY
 APPROVED AND SIGNED BY _____ DATE _____
MICHIGAN REGISTERED LAND SURVEYOR

SURVEYOR'S MICHIGAN REGISTRATION NO. _____