

LAND CORNER RECORDATION CERTIFICATE

FILING REQUIREMENT OF ACT 74, MICH. P.A. 1970

Luce Co.

3 Corners.

FOR CORNERS OF--:	LOCATED IN--:	CORNER CODE NUMBER
1. PUBLIC LAND SURVEY_____	T. <u>49</u> N. <u>X.</u> , R. <u>9</u> E. <u>W.</u>	B-1 ✓
2. PROPERTY CONTROLLING IN SECTION <u>6</u>	T. <u>49</u> N. <u>X.</u> , R. <u>9</u> E. <u>W.</u>	B1-1, 2 ✓
3. MISCELLANEOUS PROPERTY IN SECTION_____	T. _____ N. _____, R. _____ E. _____	
4. LOT NO. _____, RECORDED PLAT _____		
5. PRIVATE CLAIMS _____		

REGISTER OF DEEDS STAMP AND FILING NUMBER

I, David E. Babbitt, do hereby certify that under requirements of P.A. 74, Michigan P.A. of 1970, the corner points mentioned in lines 1 and 2 above were, in a field survey on 9-14 & 9-19, 1983, established, re-established, monumented, re-monumented, recovered or restored as expressed below and in conformance with regulations and rules therefore as required in the current manual of survey instructions of the United States Department of the Interior, Bureau of Land Management or by a decree of a court of law. Furthermore, that the corner points mentioned in lines 3, 4 and 5 above were, in a field survey on _____, 19____, found, recovered, restored, established or re-established as expressed below and in conformance with the rules of the Michigan State Board of Registration for Land Surveyors or, by a Decree of a Court of law:

A. Description of original monument and accessories and/or subsequent restoration:

E-1 North 1/4 corner of section 6. Wood Post, Q.T.'S N. Pine 7, S65°E, 13 lks,
N. Pine 6, S42°W, 20 lks.

B1-1 Witness corner to meander corner on north side of section 6.

2 East 1/16 corner on north side of section 6. Not prev. set.

B. Description of corner evidence found and/or method applied in restoring or re-establishing corner:

E-1 Found very old squared cedar post, not of record but it does fit a general line of occupation east and west. No evidence of original survey found.

E1-1 Corner set on line with N1/4 corner and NE section corner of section 6. Corner lies 899.16' west of North 1/4 corner.

2 Corner set M.P.O.L. between North 1/4 corner and NE section corner of section 6.

C. Description of monument for corner and accessories established to perpetuate locating the position of the corner:

Placed DNR Monument at all three corners. Bearings:

E-1 10" J. Pine, N70°W, 18.3' and 6" J. Pine, S83°E, 3.2' and 8" J. Pine, S1°E, 8.0' and 8" J. Pine, N11°W, 10.8'.

11-1 8" J. Pine, N66°E, 13.1' and 6" J. Pine, S28°E, 14.7' and 5" J. Pine, S9°E, 25.7' and 5" J. Pine, S86°W, 12.6'.


2 12" J. Pine, S50°W, 43.3' and 10" J. Pine, S86°W, 36.7' and 12" J. Pine, S25°E, 34.8' & 14" J. Pine, S61°E, 24.0'.

SIGNED BY David E. Babbitt DATE 10-10-83
David E. Babbitt
SURVEYOR'S MICHIGAN REGISTRATION NO. 21558 (SEAL)

FOR STATE AND UNITED STATES AGENCIES:

~~Sec. 12~~ 4" pipe with 4" aluminum cap, buried at corner.
Bearings: 10" J. Pine, S40°E, 19.5' and 12" H. Pine, N15°W, 15.7'

SIGNED BY Billy D. Buckler DATE 1-27-77
Billy D. Buckler
SURVEYOR'S MICHIGAN REGISTRATION NO. 8887

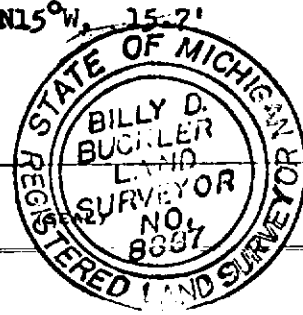

FOR STATE AND UNITED STATES AGENCIES:

SIGNED BY _____ DATE _____
CHIEF OF SURVEY PARTY
APPROVED AND SIGNED BY _____ DATE _____
MICHIGAN REGISTERED LAND SURVEYOR (SEAL)

SURVEYOR'S MICHIGAN REGISTRATION NO. _____