SEC. 2, T49N R9W.

S89°50'E, 5,302.6'

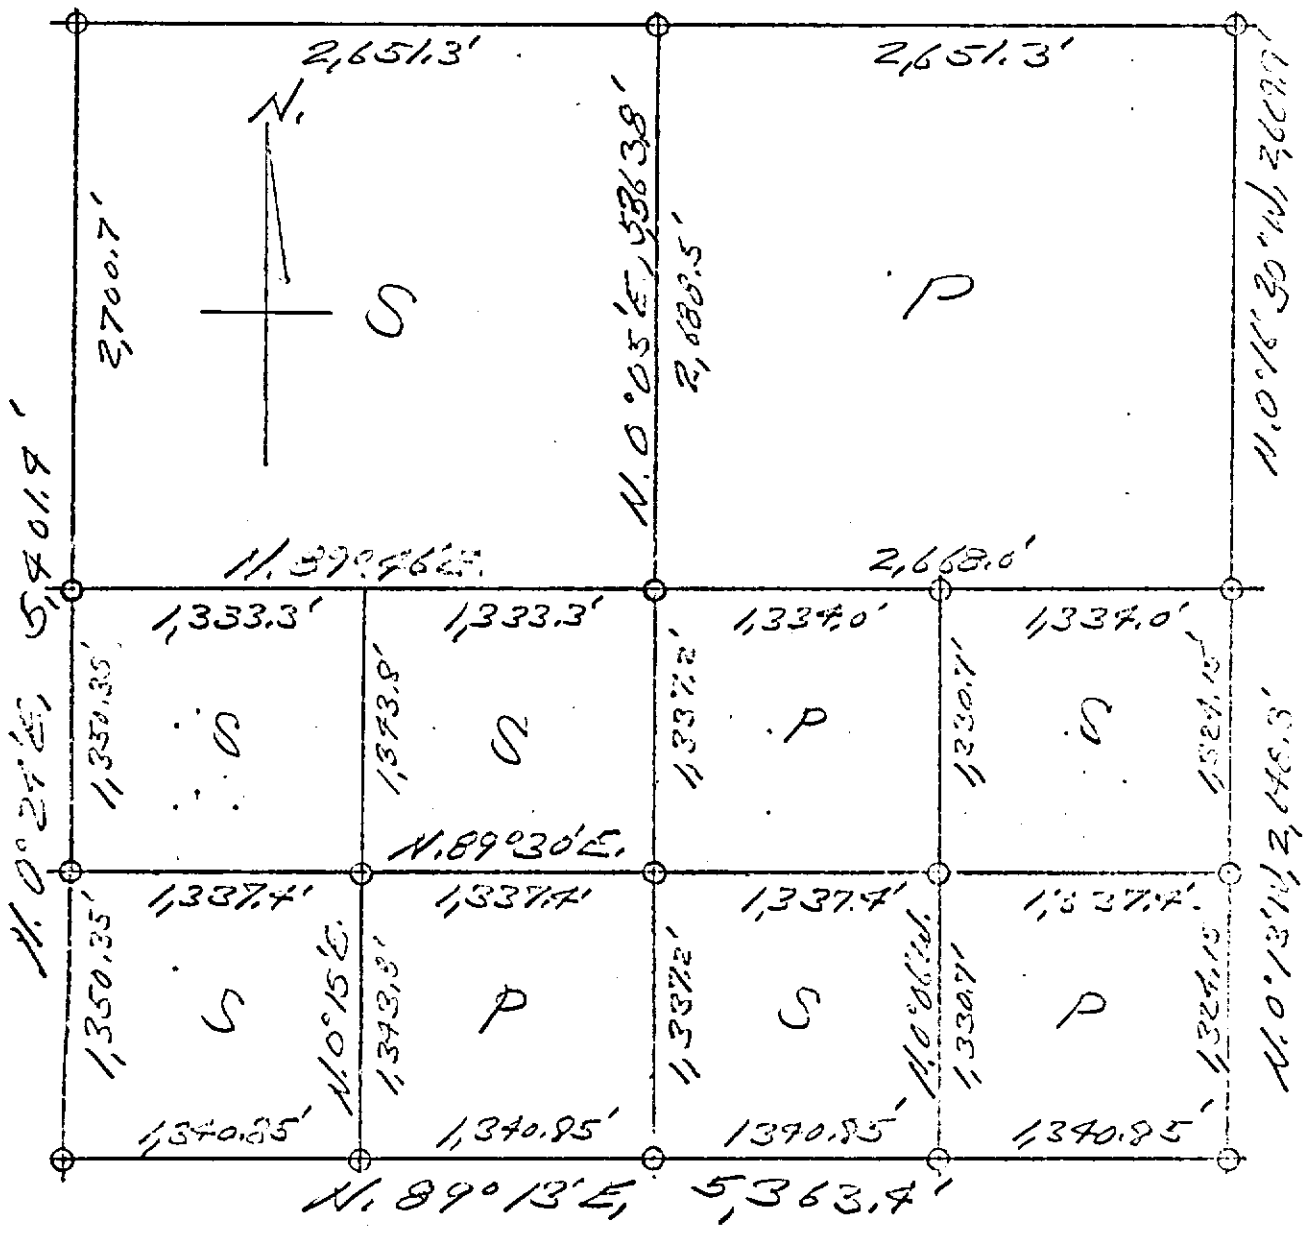

BDB
7/29/76