

LAND CORNER RECORDATION CERTIFICATE

FILING REQUIREMENT OF ACT 74, MICH. P.A.1970

LUCE COUNTY Three Corners.

FOR CORNERS OF--	LOCATED IN--	CORNER CODE NUMBER
1. PUBLIC LAND SURVEY_____	T. 49 N. R. 9 W.	L-5
2. PROPERTY CONTROLL- I2 ING IN SECTION_____	T. 49 N. R. 9 W.	I-SEC. I2 7-SEC. I2
3. MISCELLANEOUS PROPERTY IN SECTION_____	T. _____ N. S., R. _____ E. W.	
4. LOT NO. _____, RECORDED PLAT _____		
5. PRIVATE CLAIMS _____		

REGISTER OF DEEDS STAMP AND
FILING NUMBER

I, Billy D. Buckler, RLS., do hereby certify that under requirements of P.A. 74, Michigan P.A. of 1970, the corner points mentioned in lines 1 and 2 above were, in a field survey on 5/4/76, 19____, established, re-established, monumented, re-monumented, recovered or restored as expressed below and in conformance with regulations and rules therefore as required in the current manual of survey instructions of the United States Department of the Interior, Bureau of Land Management or by a decree of a court of law. Furthermore, that the corner points mentioned in lines 3, 4 and 5 above were, in a field survey on _____, 19____, found, recovered, restored, established or re-established as expressed below and in conformance with the rules of the Michigan State Board of Registration for Land Surveyors or, by a Decree of a Court of law:

A. Description of original monument and accessories and/or subsequent restoration:

- L-5; Quarter Corner bet. Secs' I2-I3; set by H. Mellen, D.S. in 1850.
Bearings were:
Y. Pine, 18", N63W, 9 Lks. and Spruce 6", S44E, 20 Lks.
- I-SEC. I2; West 1/16 Corner, on North side Sec. I2.
- 7-SEC. I2; North 1/16 Corner, on East side of Sec. I2.

B. Description of corner evidence found and/or method applied in restoring or re-establishing corner:


- L-5; Found a 5/8" Iron, buried in East-West Firelane.
- I-SEC. I2; Found two Witnesses by an un-known Surveyor;
8" J. Pine, Stub, S11E, 8.8' and 6" J. Pine Stub, North, 17.5'
Found 1 1/2" Iron Pipe, buried in South wheel track of Road.
- 7-SEC. I2; Placed Corner midway bet. Sec. Cor. to North and to
1/4 Corner to South. Corner is 7.5' West of Center of Firelane.

C. Description of monument for corner and accessories established to perpetuate locating the position of the corner:

- L-5; 5/8" Iron, Buried at Corner;
Bearings: 22" R. Pine, S20W, 35.8' and 15" R. Pine, S77E, 50.6'
- I-SEC. I2; Recorded Corner, as set by another Surveyor.
- 7-SEC. I2; Placed I2 Pipe with 4" Aluminum Cap, at Corner.
Bearings: 14" R. Pine, S87E, 21.1' and 10" J. Pine, S44W, 16.0'.

SIGNED BY Billy D. Buckler, RLS
SURVEYOR'S MICHIGAN REGISTRATION NO. 8887.

DATE 9/22/76

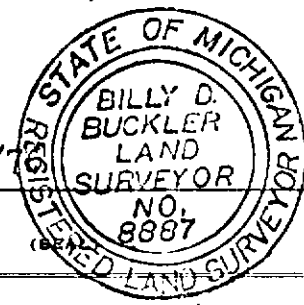

FOR STATE AND UNITED STATES AGENCIES:

SIGNED BY _____ DATE _____
CHIEF OF SURVEY PARTY
APPROVED AND SIGNED BY _____ DATE _____
MICHIGAN REGISTERED LAND SURVEYOR (SEAL)

SURVEYOR'S MICHIGAN REGISTRATION NO. _____