

MICHIGAN  
DEPARTMENT OF CONSERVATION  
FORESTRY DIVISION

# LAND CORNER RECORD

T. 49 N.R. 9 W


Luce COUNTY

DESCRIPTION OF CORNER Section Corner common to Sections 19, 20, 29, and 30

CORNER MONUMENT \_\_\_\_\_

DATE MONUMENT ~~RECORDED~~ WITNESSED 5/2/61 with L. Rubick

WITNESSES TO CORNER... 8" Red Pine N 35° E (S 20 NBT) 31 Links

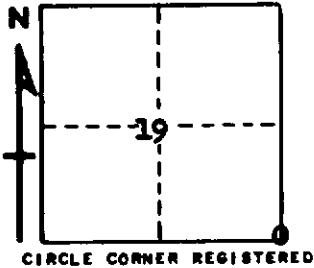

AND \_\_\_\_\_

DESCRIPTION IN DETAIL AS TO HOW CORNER WAS LOCATED AND IDENTIFIED OR RESTORED.

This corner was re-witnessed. Spruce NBT bearing N 45° E, 1/2 Link, which was marked by D.C. DeLaMater, 1952, has since died and fallen down.

SURVEYOR'S SEAL

SIGNED Billy D. Buckler DATE July 26, 1961  
REGISTERED LAND SURVEYOR  
Billy D. Buckler