

MICHIGAN
DEPARTMENT OF CONSERVATION
FORESTRY DIVISION

LAND CORNER RECORD

T. 49N N.R. 9W


Luce COUNTY

DESCRIPTION OF CORNER ¼ Cor. bet. Secs. 28-33

CORNER MONUMENT 1" pipe with 4" aluminum cap

DATE MONUMENT PLACED AND WITNESSED 8-31-70

WITNESSES TO CORNER..... 12" Red Pine (½S NBT) S62°W 7.5'

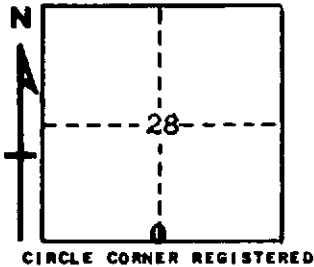

15" W. Pine (½S NBT) N15°W 39.8'

AND

DESCRIPTION IN DETAIL AS TO HOW CORNER WAS LOCATED AND IDENTIFIED OR RESTORED.

This corner replaced from one probable witness; a down cedar, badly rotted, bearing S35° 36 lks. Found another cedar down, to north-west of corner, but could not ascertain where the stump had been.

SURVEYOR'S SEAL

SIGNED *Billy D. Buckler*
Billy D. Buckler
REGISTERED LAND SURVEYOR

DATE 9-22-70