

LAND CORNER RECORDATION CERTIFICATE

FILING REQUIREMENT OF ACT 74, MICH. P.A.1970

Luce Co.

1 Corner

FOR CORNERS OF—:	LOCATED IN—:	CORNER CODE NUMBER
1. PUBLIC LAND SURVEY _____	T. <u>49</u> N. <u>8</u> , R. <u>9</u> W.	I-1
2. PROPERTY CONTROLLING IN SECTION _____	T. _____ N. _____ S., R. _____ E. _____ W.	_____
3. MISCELLANEOUS PROPERTY IN SECTION _____	T. _____ N. _____ S., R. _____ E. _____ W.	_____
4. LOT NO. _____, RECORDED PLAT _____		
5. PRIVATE CLAIMS _____		

REGISTER OF DEEDS STAMP AND
FILING NUMBER

I, Gerald L. Wiggins, do hereby certify that under requirements of P.A. 74, Michigan P.A. of 1970, the corner points mentioned in lines 1 and 2 above were, in a field survey on 8-26, 1985, established, re-established, monumented, re-monumented, recovered or restored as expressed below and in conformance with regulations and rules therefore as required in the current manual of survey instructions of the United States Department of the Interior, Bureau of Land Management or by a decree of a court of law. Furthermore, that the corner points mentioned in lines 3, 4 and 5 above were, in a field survey on _____, 19____, found, recovered, restored, established or re-established as expressed below and in conformance with the rules of the Michigan State Board of Registration for Land Surveyors or, by a Decree of a Court of law:

A. Description of original monument and accessories and/or subsequent restoration:


I-1 N.W. Section Corner of Section 2. Set by Billy D. Buckler, L.S. on 10-27-52.
1 1/2" Pipe with Concrete base. Wit: 8" J. Pine, N52°W, 67 links & 24" R. Pine, S45°E, 236 links.

B. Description of corner evidence found and/or method applied in restoring or re-establishing corner:

I-1 Found 1 1/2" pipe . Both of Buckler's bearing trees are dead. Marked new witness.

C. Description of monument for corner and accessories established to perpetuate locating the position of the corner:

I-1 1 1/2" Pipe with Concrete Base. Wit: 8" J. Pine, S33°W, 33.5'
10" J. Pine, N67°W, 54.65'
6" J. Pine, N48°E, 34.9'
6" J. Pine, S60°E, 26.85'

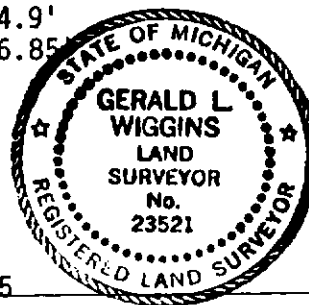

SIGNED BY _____

Gerald L. Wiggins
Gerald L. Wiggins

23521

DATE 10-10-85

(SEAL)

FOR STATE AND UNITED STATES AGENCIES: