111

LAND CORNER RECORDATION CERTIFICATE

Filing Requirement of Act 74, Mich. P.A. 1970

For corners in Luce (County)

	Located in:	Corner Code ##
1. Public Land Survey	T 49N R 9W	L6
	T ___ R ___	
	T ___ R ___	
	T ___ R ___	
2. Property Controlling	S 13 T 49N R 9W	10
in Section	S ___ T ___ R ___	
3. Miscellaneous	S ___ T ___ R ___	
Property in Sec.	S ___ T ___ R ___	

Register of Deeds Stamp & File Number

4. Lot No. _____ , Recorded Plat _____
5. Private Claims _____

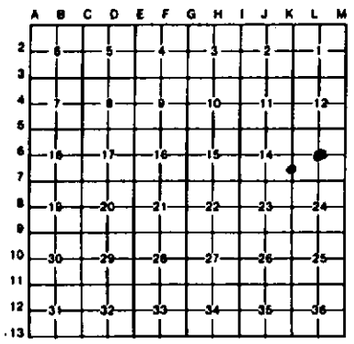

I, Stephan J. Szyszkoski , in a field survey on May 06, 1993 , 19 _____ , do hereby certify that under requirements of P.A. 74, Michigan P.A. of 1970, the corner points mentioned in lines 1 and 2 above were in conformance with regulations and rules therefore as required in the current manual of survey instructions of the United States Department of the Interior, Bureau of Land Management or by a decree of a Court of Law and/or that the corner points mentioned in lines 3, 4 and 5 above were in conformance with the rules of the Michigan Board of Land Surveyors or by a Decree of a Court of Law; established, re-established, monumented, re-monumented, recovered, found as expressed below.

NOTE: Not more than 4 corners, all in the same town and range, may be recorded on this certificate.

A. Description of original monument and accessories and/or subsequent restoration:

(L6) Center of Section 13. Corner previously recorded by Billy D. Buckler RLS, in 1977 as a 1" pipe with 4" aluminum cap placed at the position of a wood post established by an unknown surveyor. 1977 BTs: 18" R. Pine, S76E 17.7', 18" R. Pine S15W 31.7', 14" R. Pine N83W 27.7'. Found no subsequent record.

(10) South 1/16 corner between sections 13-14. Corner not established in the original survey. Found no subsequent record.

B. Description of corner evidence found and/or method applied in restoring or reestablishing corner:

(L6) Found and accepted Buckler's monument as described and at record bearing and distance from the 1977 BTs. Set measuring nails in the BTs and marked one new witness tree as described below. Determined the intersection of straight lines connecting opposite 1/4 corners to be 1.8' West and 1.0' South of the monumented corner.

(10) Found no evidence of prior monumentation at the corner position. Established the corner midway and on a straight line between 1/4 corner 1317.07' north and section corner 1317.07' south, both corners of record. At the postion for the corner, I placed a 1"x32" iron pipe capped with a 4" dia. cast aluminum MDNR tablet, appropriately stamped.

C. Description of monument for corner and accessories established to perpetuate locating the position of the corner:

(L6) Found 1" pipe with 4" MDNR cap. Blazed, scribed and set a measuring nail with tag in the following new bearing tree:
8" Spruce S71W 30.4' "1/4S BT"
Remeasured the 1977 trees:
22" R. Pine S76E 17.8'
22" R. Pine S15W 32.0'
18" R. Pine N83W 27.95'
placed squared post adjacent to the monument

STATE OF MICHIGAN
STEPHAN J. SZYSZKOSKI
LAND SURVEYOR
No. 33986
LICENSED LAND SURVEYOR

(10) Set 1" pipe with 4" MDNR cap. Blazed, scribed, and set measuring nails in the following bearing trees:
14" Beech S40E 4.1' "1/16S BT"
6" Maple S17W 18.8' "1/16S BT"
12" Y. Birch S55W 15.95' "1/16S BT"
14" Y. Birch N41E 8.4' "1/16S BT"
placed a 7" squared W. Birch post adjacent to the monument.

Signed by Stephan J. Szyszkoski Date 8-4-93

Surveyor's Michigan License No. 33986

FORM APPROVED BY MICHIGAN STATE BOARD OF LAND SURVEYORS, JAN. 20, 1971
REVISED MAY 14, 1975
REVISED JAN., 1983