

**LAND CORNER RECORDATION CERTIFICATE**  
**Filing Requirement of Act 74, Mich. P.A. 1970**

For corners in  
Luce

(County)

Located In:

Corner Code #

- |                                    |   |            |   |           |           |
|------------------------------------|---|------------|---|-----------|-----------|
| 1. Public Land Survey              | T | <u>49N</u> | R | <u>9W</u> | <u>J1</u> |
|                                    | T | <u>49N</u> | R | <u>9W</u> | <u>A5</u> |
|                                    | T | _____      | R | _____     | _____     |
|                                    | T | _____      | R | _____     | _____     |
| 2. Property Controlling in Section | S | _____      | T | _____     | R         |
|                                    | S | _____      | T | _____     | R         |
| 3. Miscellaneous Property in Sec.  | S | _____      | T | _____     | R         |
|                                    | S | _____      | T | _____     | R         |

Register of Deeds Stamp & File Number

4. Lot No. \_\_\_\_\_, Recorded Plat \_\_\_\_\_
5. Private Claims \_\_\_\_\_

Jun 25 2001

Stephan J. Szyszkoski, in a field survey on \_\_\_\_\_, 19\_\_\_\_\_,  
do hereby certify that under requirements of P.A. 74, Michigan P.A. of 1970, the corner points mentioned  
in lines 1 and 2 above were in conformance with regulations and rules therefore as required in the  
current manual of survey instructions of the United States Department of the Interior, Bureau of Land  
Management or by a decree of a Court of Law and/or that the corner points mentioned in lines 3, 4 and 5  
above were in conformance with the rules of the Michigan Board of Land Surveyors or by a Decree of a  
Court of Law; established, re-established, monumented, re-monumented, recovered, found as  
expressed below:

**NOTE: Not more than 4 corners, all in the same town and range, may be recorded  
on this certificate.**

	A	B	C	D	E	F	G	H	I	J	K	L	M
2	6		5		4		3		2		1		
3													
4	7		8		9		10		11		12		
5													
6	18		17		16		15		14		13		
7													
8	19		20		21		22		23		24		
9													
10	30		29		28		27		26		25		
11													
12	31		32		33		34		35		36		
13													

1. Description of original monument and accessories and/or subsequent restoration:


- J1) Quarter corner common to Section 2 T49NR9W and Section 35 T50NR9W. Original corner location was remonumented in 1952 by Dean C. LaMater, RLS: 1.5" pipe with concrete base. 12" J. Pine N50W 40 links, 10" J. Pine N67E 40 links. Rewitnessed and recorded in 1976 by Billy D. Buckler, RLS: 20" R.Pine S45E 68.6', 14" R.Pine S62W 45.7'
- A5) Corner common to Sections 7-18 T49N-R9W and 12-13 T49N-R10W. Corner remonumented by Billy D. Buckler in 1958: DNR monument. 7" J. Pine N68W 66 links, 9" J. Pine S52W 46.5 links. Rewitnessed and recorded in 1991 by G.L. Wiggins, RLS: DNR monument. 10" J. Pine S15E 64.55', 6" J. Pine S45E 41.3', 8" J. Pine N89E 41.65', 12" J. Pine S52W 30.7'.

3. Description of corner evidence found and/or method applied in restoring or reestablishing corner:

- J1) Recovered bent 1.5" dia. iron pipe set in a concrete base at record bearing and distance from the 1976 witnesses. The R.Pine SE is in good condition. All other NBTs have either been cut or are down. Remonumented the corner at the 1976 position and made new witnesses as described below.
- A5) Recovered the 1958 monument, a 1" ID iron pipe with 4" brass MI Dept. of Conservation cap, at record bearing and distance from the remains of the 1958 witnesses, the J.Pine NW a dead 10' snag, the J.Pine SW cut off at 5' high and leaning. Also recovered the cut stump remains of the 1991 witnesses at record bearing and distance. Left the monument in place and made new witnesses.

2. Description of monument for corner and accessories established to perpetuate locating the position of the corner:

- |   |  |
|---|--|
| J1) Drove a 1" ID iron pipe with 4" lum. MDNR cap. Blazed, scribed, and set measuring nails in the following:<br>2" R. Pine S44E 68.8'    1/4S NBT"<br>6" R. Pine N52W 60.25'    do<br>10" R. Pine N61E 26.65'    do<br>12" R. Pine S30W 54.1'    do<br>Bearings are magnetic. Distances are to all with tag. | (A5) Found 1" ID iron pipe with brass cap. Set nails/tags in the prior NBTs:<br>J.Pine snag N67W 43.7' scribing plain<br>J. Pine snag S50W 32.3'    do<br>8" J.Pine stump East 41.8' do<br>Blazed, scribed and set measuring nails in the following:<br>3" J. Pine N39E 21.0'    "S7 NBT"<br>3" J. Pine N84E 41.9'    do<br>Bearings are magnetic. Dist. to nails with tags. |
|---|--|

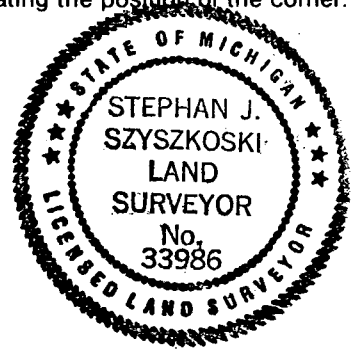

Signed by Stephan J. Szyszkoski Date 7/25/01

Surveyor's Michigan License No. 33986