


**LAND CORNER RECORDATION CERTIFICATE**  
**Filing Requirement of Act 74, Mich. P.A. 1970**

For corners in

<u>Luce</u> (County)	Located In:	Corner Code #	
1. Public Land Survey	T ___ R ___	_____	_____
	T ___ R ___	_____	_____
	T ___ R ___	_____	_____
	T ___ R ___	_____	_____
2. Property Controlling in Section	S <u>32</u> T <u>49N</u> R <u>9W</u>	_____	1
	S <u>32</u> T <u>49N</u> R <u>9W</u>	_____	16
3. Miscellaneous Property in Sec.	S ___ T ___ R ___	_____	_____
	S ___ T ___ R ___	_____	_____

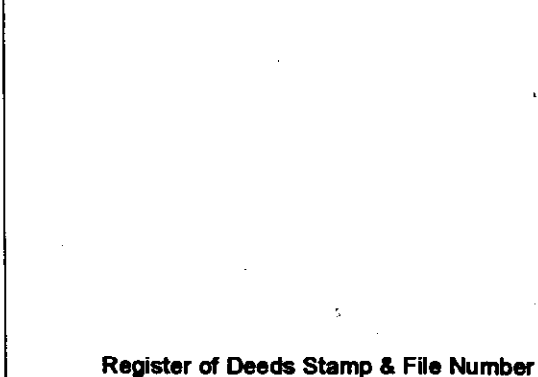

4. Lot No. \_\_\_\_\_, Recorded Plat \_\_\_\_\_  
 5. Private Claims \_\_\_\_\_

16 May 13 2002  
 1 Nov 25 2001

I, Stephan J. Szyszkoski, in a field survey on \_\_\_\_\_, 20\_\_ do hereby state that under requirements of P.A. 74, Michigan P.A. of 1970, the corner points mentioned in lines 1 and 2 above were in conformance with regulations and rules therefore as required in the current manual of survey instructions of the United States Department of the Interior, Bureau of Land Management or by a decree of a Court of Law and /or that the corner points mentioned in lines 3, 4 and 5 above were in conformance with the rules of the Michigan Board of Land Surveyors or by a Decree of a Court of Law; established, re-established, monumented, recovered, found as expressed below:

**NOTE:** Not more than 2 corners, all in the same town and range, may be recorded on this certificate.

	A	B	C	D	E	F	G	H	I	J	K	L	M
1													
2	6		5		4		3		2		1		
3													
4	7		8		9		10		11		12		
5													
6	18		17		16		15		14		13		
7													
8	19		20		21		22		23		24		
9													
10	30		29		28		27		26		25		
11													
12	31		32		33		34		35		36		
13													

**A. Description of original monument and accessories and/or subsequent restoration:**


(1-Sec. 32) West 1/16 corner between Sections 29-32. Corner not established in the original survey.  
 (16-Sec. 32) East 1/16 corner between Sec. 32 T49N-R09W and Sec. 5 T48N-R09W. Not established in the original survey. Found no subsequent record.

**B. Description of corner evidence found and/or method applied in restoring or reestablishing corner:**

(1-Sec. 32) Established the corner midway and on a line of mean true bearing between Quarter and Section corners 1324.10' east and west.  
 (16-Sec. 32) Established the corner midway and on a line of mean true bearing between Section and Quarter corners 1328.45' east and west. From the position thus established, I found a 3/4" iron pipe and adjacent scribed post, not of record, South, 5.2' distant.

**C. Description of monument for corner and accessories established to perpetuate locating the position of the corner:**

(1) Set 1"IDx36" I.pipe with 4" alum. MDNR cap. Blazed, scribed, and set measuring nails in: 4" Maple S14W 3.4'      "W1/16 BT" 5" Maple S63E 9.55'      do 5" Maple N24W 25.5'      do 6" Balsam S65W 27.7'      do Placed cedar post adjacent. Bearings are magnetic. Distances are to nail with tag.	(16) Set 1"IDx36" I.pipe with 4" alum. MDNR cap. Blazed, scribed, and set measuring nails in: 6" twin Balsam N52E 12.8'      "E1/16 BT" 7" R.Pine S80E 29.5'      do 7" R.Pine S17W 30.65'      do 12" R.Pine S48W 19.3'      do Bearings are magnetic. Distances are to nail with tag.
--	--

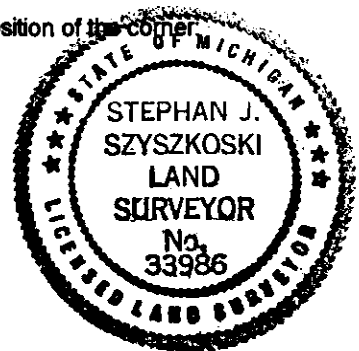

Signed by Stephan J. Szyszkoski  
 Surveyor's Michigan License No. 33986

Date 8/19/02