


**LAND CORNER RECORDATION CERTIFICATE**  
**Filing Requirement of Act 74, Mich. P.A. 1970**

For corners in

<u>Luce</u> (County)	Located In:	Corner Code #	
1. Public Land Survey	T <u>49N</u> R <u>9W</u>	<u>B11</u>	
	T <u>    </u> R <u>    </u>	<u>    </u>	
	T <u>    </u> R <u>    </u>	<u>    </u>	
	T <u>    </u> R <u>    </u>	<u>    </u>	
2. Property Controlling in Section	S <u>    </u> T <u>    </u> R <u>    </u>	<u>    </u>	
	S <u>    </u> T <u>    </u> R <u>    </u>	<u>    </u>	
3. Miscellaneous Property in Sec.	S <u>    </u> T <u>    </u> R <u>    </u>	<u>    </u>	
	S <u>    </u> T <u>    </u> R <u>    </u>	<u>    </u>	

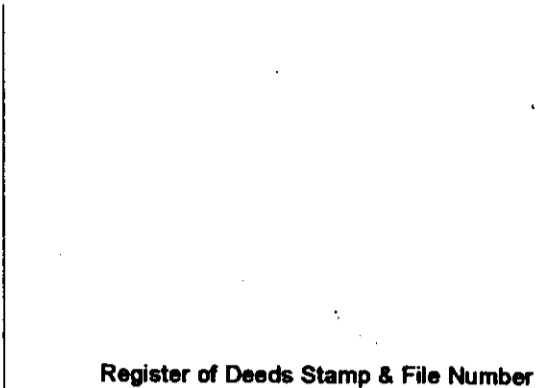

4. Lot No. \_\_\_\_\_, Recorded Plat \_\_\_\_\_  
 5. Private Claims \_\_\_\_\_

Dec 04 2001

I, Stephan J. Szyszkoski, in a field survey on \_\_\_\_\_, 20\_\_ do hereby state that under requirements of P.A. 74, Michigan P.A. of 1970, the corner points mentioned in lines 1 and 2 above were in conformance with regulations and rules therefore as required in the current manual of survey instructions of the United States Department of the Interior, Bureau of Land Management or by a decree of a Court of Law and /or that the corner points mentioned in lines 3, 4 and 5 above were in conformance with the rules of the Michigan Board of Land Surveyors or by a Decree of a Court of Law; established, re-established, monumented, recovered, found as expressed below:

NOTE: Not more than 2 corners, all in the same town and range, may be recorded on this certificate.


	A	B	C	D	E	F	G	H	I	J	K	L	M
1													
2	6		5		4		3		2		1		
3													
4	7		8		9		10		11		12		
5													
6	18		17		16		15		14		13		
7													
8	19		20		21		22		23		24		
9													
10	30		29		28		27		26		25		
11	●												
12	31		32		33		34		35		36		

A. Description of original monument and accessories and/or subsequent restoration:  
 (B11) Quarter corner common to Sections 30-31. 1972: Reestablished by Billy D. Buckler RLS: Corner reestablished by single proportionate measurement bet. two Sec. Cors. No evidence of original corner. Placed 1" pipe with 4" aluminum cap at corner. New bearings 10" Hemlock S5W 18.3', 20" twin Hemlock N45E 9.8'

B. Description of corner evidence found and/or method applied in restoring or reestablishing corner:  
 (B11) Found the 1972 monument as described, in good condition, and at record bearing and distance from the noted accessories, both in good condition with overgrown blazes. Measurements to adjacent Section corners show the monument is 2.74' east of the intended proportionate position and 0.45' south of a line between. I accept the monument as a careful and faithful reestablishment of the position of the original corner.

C. Description of monument for corner and accessories established to perpetuate locating the position of the corner:

(B11) Fd. 1" ID 1. pipe with 4" alum. MDNR cap. Blazed, scribed, and set measuring nails in:  
 \* 30" Hemlock N36E 9.65' "1/4S"  
 \* 16" Hemlock S7W 18.4' "1/4S"  
 12" Hemlock S53E 17.4' "1/4S NBT"  
 5" Maple N63W 0.95' do  
 Set cedar post adjacent. Bearings are magnetic. Distances are to nail with tag. \* denotes 1972 NBT.

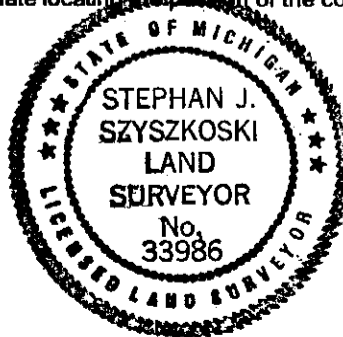

Signed by Stephan J. Szyszkoski  
 Surveyor's Michigan License No. 33986

Date 8/15/02