


LAND CORNER RECORDATION CERTIFICATE
Filing Requirement of Act 74, Mich. P.A. 1970 as Amended

For corners in

<u>Luce</u> (County)	Located In:	Corner Code #	
1. Public Land Survey	T49N R 09W	I 3	
	T_____ R_____	_____	
	T_____ R_____	_____	
2. Property Controlling in Section	S_____ T_____ R_____	_____	
	S_____ T_____ R_____	_____	
3. Miscellaneous Property in Sec.	S_____ T_____ R_____	_____	
	S_____ T_____ R_____	_____	
4. Lot No. _____, Recorded Plat _____			
5. Private Claims			

Register of Deeds Stamp & File Number

I, Stephan J. Szyszkoski, in a field survey on Sept. 6, 2006 do hereby state that under requirements of P.A. 74, Michigan P.A. of 1970, the corner points mentioned in lines 1 and 2 above were in conformance with regulations and rules therefore as required in the current manual of survey instructions of the United States Department of the Interior, Bureau of Land Management or by a decree of a Court of Law and /or that the corner points mentioned in lines 3, 4 and 5 above were in conformance with the rules of the Michigan Board of Land Surveyors or by a Decree of a Court of Law; established, re-established, monumented, recovered, found as expressed below:

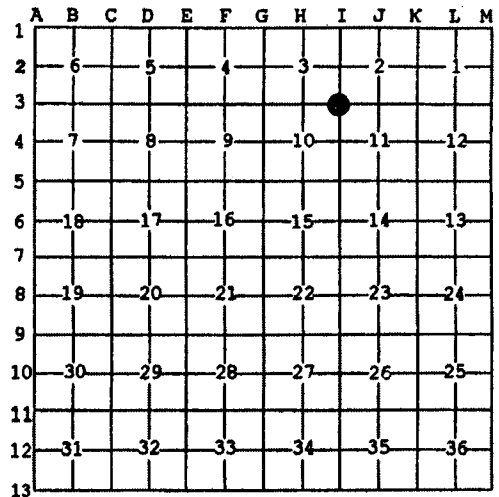

NOTE: Not more than 2 corners, all in the same town and range, may be recorded on this certificate.

A. Description of original monument and accessories and/or subsequent restoration:
(I3) Corner common to Sections 2-3-10-11. 1850 - Established by Harvey Mellen, Deputy Surveyor: Set post. Spruce Pine 10 N33E 155 links, Y.Pine 12 S79 1/4W 357 links. 1958 - Perpetuated by Billy D. Buckler, RLS: Replaced corner as set by Marcus Schaaf, Reg. Surveyor. Found 2" Iron pipe in place with remains of Jackpine B.T. N33E 155 links. Found wood slabs set at B.T. sites. Corner lies in intersection of N-S-E-W firelanes. Set 1" pipe with 4" brass cap. New BTs: 12" Jackpine S69W 75 links, 13" Jackpine S70E 45 links.

B. Description of corner evidence found and/or method applied in restoring or reestablishing corner:
(I3) Recovered the 1958 monument, a 1" ID I.pipe with 4" brass MI Dept. of Conservation cap, in good condition, in the intersection of firelanes N-S-E-W. The original BTs were not recovered. The 1958 NBTs were not recovered. Verified the position of the monument with respect to 1/16 corner and 1/4 corner to the east, the 1/16 corner having been reestablished by Mr. Buckler midway and on line between I3 and J3, and found all three to be in substantial accord with the record. Accepted the monument as a careful and faithful perpetuation of the position of the original corner.

C. Description of monument for corner and accessories established to perpetuate locating the position of the corner:
(I3) Found 1" ID I.pipe with 4" brass MI Dept. of Conservation cap. Set measuring nail with MDNR tag in the side of the following trees:
12" J.Pine N15E 140.9' mrkd "S2 NBT"
10" J.Pine N31E 67.25' do
10" J.Pine N64E 65.65' do
5" R.Pine S78E 105.2' "S11 NBT"
Bearings are magnetic.



Signed by Stephan J. Szyszkoski Date 10/25/07

Surveyor's Michigan License No. 33986