

LAND CORNER RECORDATION CERTIFICATE
Filing Requirement of Act 74, Mich. P.A. 1970 as Amended

For corners in

<u>Luce</u> (County)	Located In:	Corner Code #
1. Public Land Survey	T ___ R ___	_____
	T ___ R ___	_____
	T ___ R ___	_____
	S <u>11</u> T <u>49N</u> R <u>09W</u>	<u>4</u>
2. Property Controlling in Section	S <u>11</u> T <u>49N</u> R <u>09W</u>	<u>9</u>
	S ___ T ___ R ___	_____
3. Miscellaneous Property in Sec.	S ___ T ___ R ___	_____
	S ___ T ___ R ___	_____
4. Lot No. _____, Recorded Plat _____		
5. Private Claims		

Register of Deeds Stamp & File Number

	A	B	C	D	E	F	G	H	I	J	K	L	M
1													
2	6		5		4		3		2		1		
3													
4	7		8		9		10		11		12		
5													
6	18		17		16		15		14		13		
7													
8	19		20		21		22		23		24		
9													
10	30		29		28		27		26		25		
11													
12	31		32		33		34		35		36		
13													

I, Stephan J. Szyszkoski, in a field survey on _____, 20____ do hereby state that under requirements of P.A. 74, Michigan P.A. of 1970, the corner points mentioned in lines 1 and 2 above were in conformance with regulations and rules therefore as required in the current manual of survey instructions of the United States Department of the Interior, Bureau of Land Management or by a decree of a Court of Law and /or that the corner points mentioned in lines 3, 4 and 5 above were in conformance with the rules of the Michigan Board of Land Surveyors or by a Decree of a Court of Law; established, re-established, monumented, recovered, found as expressed below:

NOTE: Not more than 2 corners, all in the same town and range, may be recorded on this certificate.

A. Description of original monument and accessories and/or subsequent restoration:

(4-Sec. 11) Northwest 1/16 corner, Section 11. Not established in the original survey.

(9-Sec. 11) East 1/16 corner, Sec. 11. Not established in the original survey.

B. Description of corner evidence found and/or method applied in restoring or reestablishing corner:


(4-Sec. 11) Established the corner at the intersection of straight lines connecting opposite 1/16 corners.

(9-Sec. 11) Established the corner midway and on a straight line between Center of Section 1336.77' west and Quarter corner 1336.77' east.

C. Description of monument for corner and accessories established to perpetuate locating the position of the corner:

(4) Set 1"IDx36" I.pipe with 4" alum. MDNR cap.
 Set measuring nail with MDNR tag in the side of:
 6" J.Pine N30W 19.46' mrkd "NW1/16 BT"
 8" R.Pine N73W 34.48' do
 6" J.Pine N75E 43.92' do
 11" R.Pine S46W 77.01' do
 Bearings are magnetic.

(9) Set 1"IDx36" I.pipe with 4" alum. MDNR cap.
 Set measuring nail with MDNR tag in the side of:
 15" R.Pine N14W 8.55' mrkd "E1/16 BT"
 17" R.Pine N47E 19.85' do
 14" R.Pine S84E 23.96' do
 12" R.Pine S65W 25.5' do
 Bearings are magnetic.

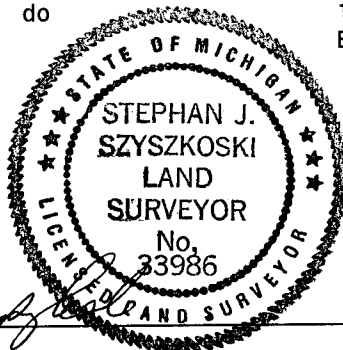

Signed by Stephan J. Szyszkoski Date 10/25/07

Surveyor's Michigan License No. 33986

For the Michigan Department of Natural Resources, Office of Land and Facilities