

**LAND CORNER RECORDATION CERTIFICATE**  
**Filing Requirement of Act 74, Mich. P.A. 1970 as Amended**

For corners in

<u>Luce</u> (County)	Located In:	Corner Code #
1. Public Land Survey	T <u>    </u> R <u>    </u>	<u>          </u>
	T <u>    </u> R <u>    </u>	<u>          </u>
	T <u>    </u> R <u>    </u>	<u>          </u>
2. Property Controlling in Section	S <u>11</u> T <u>49N</u> R <u>09W</u>	<u>5</u>
3. Miscellaneous Property in Sec.	S <u>11</u> T <u>49N</u> R <u>09W</u>	<u>6</u>
	S <u>    </u> T <u>    </u> R <u>    </u>	<u>          </u>
	S <u>    </u> T <u>    </u> R <u>    </u>	<u>          </u>
4. Lot No. <u>          </u> , Recorded Plat <u>          </u>		
5. Private Claims		

Register of Deeds Stamp & File  
Number

	A	B	C	D	E	F	G	H	I	J	K	L	M
1													
2	6		5		4		3		2		1		
3													
4	7		8		9		10		11		12		
5													
6	18		17		16		15		14		13		
7													
8	19		20		21		22		23		24		
9													
10	30		29		28		27		26		25		
11													
12	31		32		33		34		35		36		
13													

I, Stephan J. Szyszkoski, in a field survey on Sept 27, 2007 do hereby state that under requirements of P.A. 74, Michigan P.A. of 1970, the corner points mentioned in lines 1 and 2 above were in conformance with regulations and rules therefore as required in the current manual of survey instructions of the United States Department of the Interior, Bureau of Land Management or by a decree of a Court of Law and /or that the corner points mentioned in lines 3, 4 and 5 above were in conformance with the rules of the Michigan Board of Land Surveyors or by a Decree of a Court of Law; established, re-established, monumented, recovered, found as expressed below:

**NOTE: Not more than 2 corners, all in the same town and range, may be recorded on this certificate.**

A. Description of original monument and accessories and/or subsequent restoration:

(5-Sec. 11) North 1/16 corner, Section 11. Not established in the original survey.

(6-Sec. 11) Northeast 1/16 corner, Section 11. Not established in the original survey.

B. Description of corner evidence found and/or method applied in restoring or reestablishing corner:


(5-Sec. 11) Established the corner midway and on a straight line between Quarter corner 1278.34' north and Center of Section 1278.34' south. From the position thus established, I found a sq'd post, an approximate corner by others, S14E 50 feet distant, which I did not accept for the position of the corner.

(6-Sec. 11) Established the corner at the intersection of straight lines connecting opposite 1/16 corners.

C. Description of monument for corner and accessories established to perpetuate locating the position of the corner:

(5) Set 1"IDx36" I.pipe with 4" alum. MDNR cap.  
Set measuring nail with MDNR tag in the side of:  
10" J.Pine S01W 7.8' mrkd "N1/16 BT"  
6" J.Pine West 16.7' do  
7" J.Pine N68E 25.7' do  
7" J.Pine S47E 47.86' do  
Bearings are magnetic.

(6) Set 1"IDx36" I.pipe with 4" alum. MDNR cap.  
Set measuring nail with MDNR tag in the side of:  
6" J.Pine S11W 4.7' mrkd "NE1/16 BT"  
6" J.Pine S74W 9.89' do  
8" J.Pine S62E 8.36' do  
14" R.Pine N13W 28.58' do  
Bearings are magnetic.

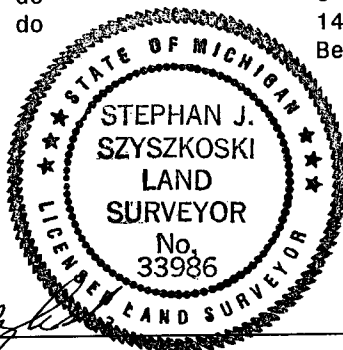

Signed by Stephan J. Szyszkoski Date 10/25/07

Surveyor's Michigan License No. 33986

For the Michigan Department of Natural Resources, Office of Land and Facilities