

MICHIGAN  
DEPARTMENT OF CONSERVATION  
FORESTRY DIVISION

# LAND CORNER RECORD

T. 49N N.R. 16N


Luce COUNTY

DESCRIPTION OF CORNER West 1/16 Cor. bet. Sec. 8 & 17

CORNER MONUMENT Dept. Monument buried in center of east and west fireline road

DATE MONUMENT PLACED AND WITNESSED 11-10-70

WITNESSES TO CORNER..... 16" R. Pine N13°W 16.5'

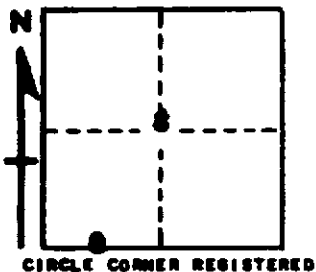

18" R. Pine S49°E 28.2'

AND

DESCRIPTION IN DETAIL AS TO HOW CORNER WAS LOCATED AND IDENTIFIED OR RESTORED.

This corner placed midway bet. Sec. Cor. to west and  $\frac{1}{2}$  Cor. to East.

SURVEYOR'S SEAL

SIGNED *Billy D. Buckler*  
Billy D. Buckler DATE 1-29-71  
REGISTERED LAND SURVEYOR