

MICHIGAN
DEPARTMENT OF CONSERVATION
FORESTRY DIVISION

2
LAND CORNER RECORD

T. 49N N.R. 10W


Lucas COUNTY

DESCRIPTION OF CORNER East 1/16 Cor. bet. Sec. 8 & 17

CORNER MONUMENT Dept. monument buried in center of East and West fireline road.

DATE MONUMENT PLACED AND WITNESSED 11-10-70

WITNESSES TO CORNER..... 8" R. Pine S2 $\frac{1}{2}$ ⁰E 29.6'

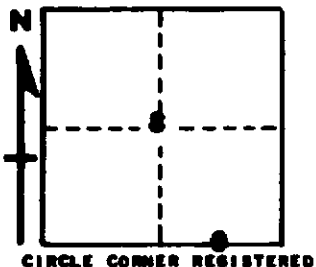

10" R. Pine N20⁰E 42.8'

AND

DESCRIPTION IN DETAIL AS TO HOW CORNER WAS LOCATED AND IDENTIFIED OR RESTORED.

This corner placed midway and on line between Sec. Cor. to East and $\frac{1}{4}$ Cor. to west.

SURVEYOR'S SEAL

SIGNED *Billy D. Buckler*
Billy D. Buckler
REGISTERED LAND SURVEYOR

DATE 1-29-71