

LAND CORNER RECORDATION CERTIFICATE

FILING REQUIREMENT OF ACT 74, MICH. P.A.1970

Luce Co.

Two Corners.

FOR CORNERS OF--	LOCATED IN--	CORNER CODE NUMBER
1. PUBLIC LAND SURVEY _____	T. <u>49</u> N. <u>X</u> , R. <u>10</u> E. <u>W</u> .	A-8, C-10
2. PROPERTY CONTROLLING IN SECTION _____	T. _____ N. _____ S., R. _____ E. _____ W.	_____
3. MISCELLANEOUS PROPERTY IN SECTION _____	T. _____ N. _____ S., R. _____ E. _____ W.	_____
4. LOT NO. _____, RECORDED PLAT _____		
5. PRIVATE CLAIMS _____		

REGISTER OF DEEDS STAMP AND FILING NUMBER

I, Billy D. Buckler, do hereby certify that under requirements of P.A. 74, Michigan P.A. of 1970, the corner points mentioned in lines 1 and 2 above were, in a field survey on 11/7, 1977, established, re-established, monumented, re-monumented, recovered or restored as expressed below and in conformance with regulations and rules therefore as required in the current manual of survey instructions of the United States Department of the Interior, Bureau of Land Management or by a decree of a court of law. Furthermore, that the corner points mentioned in lines 3, 4 and 5 above were, in a field survey on _____, 19____, found, recovered, restored, established or re-established as expressed below and in conformance with the rules of the Michigan State Board of Registration for Land Surveyors or, by a Decree of a Court of law:


- A. Description of original monument and accessories and/or subsequent restoration:
- A-8 Quarter Corner on West side Sec. 19, set by John Burt, D.S. in 1841. Bearings were: N. Pine 8", N5°E, 37 lks. and N. Pine 12", N30°W, 25 lks.
 - C-10 Quarter Corner bet. Sec's. 29-30, set by George H. Cannon D.S. in 1854. Bearings were: W. Pine 16", S60°W, 17 lks. and W. Pine 10", S32°E, 22 lks.

- B. Description of corner evidence found and/or method applied in restoring or re-establishing corner:
- A-8 Re-witnessed corner as recorded 5/6/58. 1958 bearings were cut during a timber cutting operation.
 - C-10 Re-witnessed corner as set by myself 6/2/58. The 1958 bearings were cut during a timber cutting operation.

- C. Description of monument for corner and accessories established to perpetuate locating the position of the corner:
- | | |
|---------------------------|----------------------------|
| A-8 Marked New Bearings: | C-10 Marked New Bearings: |
| 6" R. Pine, N36°E, 121.6' | 14" W. Pine, N37°W, 131.8' |
| 6" R. Pine, S12°W, 61.75' | 6" J. Pine, N61°E, 39.4' |

SIGNED BY Billy D. Buckler
 Billy D. Buckler
 SURVEYOR'S MICHIGAN REGISTRATION NO. 8887

DATE 4-10-78

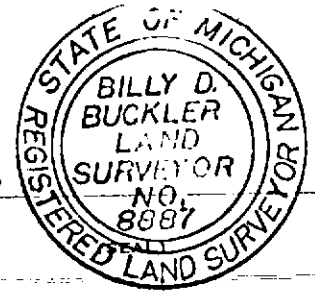

FOR STATE AND UNITED STATES AGENCIES:

SIGNED BY _____ DATE _____
CHIEF OF SURVEY PARTY

APPROVED AND SIGNED BY _____ DATE _____
MICHIGAN REGISTERED LAND SURVEYOR

SURVEYOR'S MICHIGAN REGISTRATION NO. _____