LAND CORNER RECORDATION CERTIFICATE
Filing Requirement of Act 74, Mich. P.A. 1970 as Amended

For corners in

Luce (County) Located In: Corner Code #

1. Public Land Survey		T 49N	R 10W	MC north of K2
		T	R	
		T	R	
	S	T	R	
2. Property Controlling	S 2	T 49N	R 10W	MC North of cor. #9
in Section	S	T	R	
3. Miscellaneous	S	T	R	
Property in Sec.	S	T	R	

Register of Deeds Stamp & File Number

4. Lot No. _____ , Recorded Plat_____

5. Private Claims

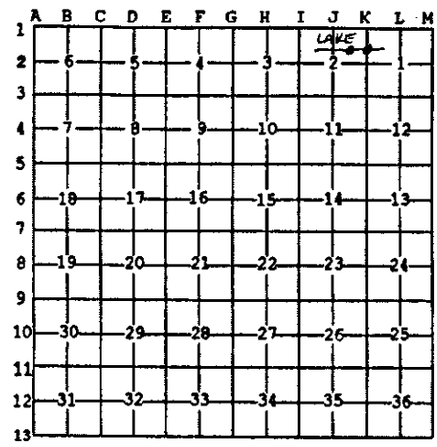

Nov 09 2004

I, Stephan J. Szyszkoski, in a field survey on _____, 20 ____ do hereby state that under requirements of P.A. 74, Michigan P.A. of 1970, the corner points mentioned in lines 1 and 2 above were in conformance with regulations and rules therefore as required in the current manual of survey instructions of the United States Department of the Interior, Bureau of Land Management or by a decree of a Court of Law and /or that the corner points mentioned in lines 3, 4 and 5 above were in conformance with the rules of the Michigan Board of Land Surveyors or by a Decree of a Court of Law; established, re-established, monumented, recovered, found as expressed below:

NOTE: Not more than 2 corners, all in the same town and range, may be recorded on this certificate.

A. Description of original monument and accessories and/or subsequent restoration:

(MC north of K2) Witness corner to MC on shore of Lake Superior, on the Section line between Sections 1 and 2. Established and monumented with a capped T-iron by Eino Sainio, PS 7873, in 1995.
(MC north of 9) A monumented point on the East N-S 1/16 line, Section 2, near the shore of Lake Superior, north of the East 1/16 corner, Sec. 2. Not established in the original survey. Established and monumented in 1995 by Eino Sainio, PS 7873 and subsequently used to control the surveyed boundaries of several parcels by Keith Waters, PS 33142.

B. Description of corner evidence found and/or method applied in restoring or reestablishing corner:

(MC north of K2) Recovered and accepted the 1995 monument. The T-iron was found to be 842.11' north of K2 (842.4' Sainio record). The GLO record from K2 north to the Meander Corner is 1003.2' (15.20 chains). Thus, this monument is 161.1' south of the GLO record position for the Meander Corner between Sections 1 and 2.
(MC north of 9) Recovered and accepted a capped T-iron, in accord with Mr. Sainio's 1995 survey. This monument is located 727.69' north of the monumented East 1/16 corner of Section 2.

C. Description of monument for corner and accessories established to perpetuate locating the position of the corner:

(MC-K2) Fd. capped T-iron with metal post adjacent. Set measuring nails in:

16" W.Pine N76E 45.75'	mrkd "WC BT"
5" Maple N01W 3.35'	do
7" W.Pine N83W 27.3'	do
6" Maple S31W 19.4'	do

Bearings are magnetic. Distances are to nail with tag.

(MC-9) Found capped T-iron with metal post adjacent. Set measuring nails in:

8" R.Pine S79W 25.2'	mrkd "WC BT"
14" R.Pine N67W 24.3'	do
16" W.Pine N78E 42.7'	do
14" R.Pine N62E 17.9'	do

Bearings are magnetic. Distances are to nail with tag.

STATE OF MICHIGAN
STEPHAN J. SZYSZKOSKI
LAND SURVEYOR
No. 33986
LICENSED LAND SURVEYOR

Signed by Stephen J. Szyszkoski Date 12/20/04

Surveyor's Michigan License No. 33986

For the Michigan Department of Natural Resources, Office of Land and Facilities

FORM APPROVED BY MICHIGAN STATE BOARD OF PROFESSIONAL SURVEYORS, JAN. 28, 1971
Revised May 14, 1975
Revised Jan., 1983
Revised Oct., 1995