

**LAND CORNER RECORDATION CERTIFICATE**  
**Filing Requirement of Act 74, Mich. P.A. 1970 as Amended**

For corners in

Luce	Located In:	Corner Code #
(County)		
1. Public Land Survey	T <u>49NR</u> <u>10W</u>	<u>G2</u>
	T <u>49NR</u> <u>10W</u>	<u>MC north of G2</u>
	T <u>    </u> <u>    </u>	<u>    </u>
	S <u>    </u> <u>    </u>	<u>    </u>
2. Property Controlling in Section	S <u>    </u> <u>    </u>	<u>    </u>
	S <u>    </u> <u>    </u>	<u>    </u>
3. Miscellaneous Property in Sec.	S <u>    </u> <u>    </u>	<u>    </u>
	S <u>    </u> <u>    </u>	<u>    </u>

Register of Deeds Stamp & File Number

4. Lot No. \_\_\_\_\_, Recorded Plat \_\_\_\_\_  
 5. Private Claims \_\_\_\_\_

Dec 01 2004

I, Stephan J. Szyszkoski, in a field survey on \_\_\_\_\_, 20\_\_\_\_ do hereby state that under requirements of P.A. 74, Michigan P.A. of 1970, the corner points mentioned in lines 1 and 2 above were in conformance with regulations and rules therefore as required in the current manual of survey instructions of the United States Department of the Interior, Bureau of Land Management or by a decree of a Court of Law and /or that the corner points mentioned in lines 3, 4 and 5 above were in conformance with the rules of the Michigan Board of Land Surveyors or by a Decree of a Court of Law; established, re-established, monumented, recovered, found as expressed below:

	A	B	C	D	E	F	G	H	I	J	K	L	M
1													
2	6	5					4	3	2	1			
3													
4	7	8					9	10	11	12			
5													
6	18	17	16	15	14	13							
7													
8	19	20	21	22	23	24							
9													
10	30	29	28	27	26	25							
11													
12	31	32	33	34	35	36							
13													

**NOTE: Not more than 2 corners, all in the same town and range, may be recorded on this certificate.**

**A. Description of original monument and accessories and/or subsequent restoration:**


(G2) Quarter corner common to Sections 3-4. 1957 - Corner replaced by Billy D. Buckler, RLS, at position perpetuated by Marcus Schaff, Reg. Surveyor. Found 2" pipe in center of N-S fire-lane. Found one jackpine 8T in poor condition. Also found NBT by H. Lawrence, Reg. Surveyor. Set 3/8"x34" iron bar 6" below surface. 7" Red Pine N32W 95 links, 20" Red Pine S55E 83 links.  
 (MC north of G2) Meander corner between Sections 3 and 4 on Lake Superior. 1957 - Remonumented by Billy D. Buckler, RLS, at position of an H. Lawrence, RLS, post found on ground and from a probable White Birch 0BT S10W 116 links. Set 1" iron pipe with 4" brass cap. 16" White Birch S5E 130 links (old Lawrence NBT), 8" Red Pine N65E 126.5 links. 1976 or 1977 - Billy D. Buckler notes in a record dated 1984 that the W. Birch NBT is dead and recorded new witnesses: 14" R. Pine N38W 43.0', 8" R. Pine N65E 83.49'.

**B. Description of corner evidence found and/or method applied in restoring or reestablishing corner:**

(G2) Recovered accepted the 3/8" iron bar at record bearing and distance from the 1957 NBTs, both in good condition. The Jack Pine 0BT noted in the 1957 record was not recovered.  
 (MC north of G2) Recovered the 1957 monument, a 1" pipe with brass cap, set plumb in the ground with the exposed portion bent over. The 1984 NBTs were found in good condition at record bearing and distance. Removed the 1957 monument and replaced it with a 5/8"x24" rebar, buried in the east rut of the fire lane in which it falls. The monument is 316.88' north of the Quarter corner between Sections 3 and 4.

**C. Description of monument for corner and accessories established to perpetuate locating the position of the corner:**

(G2) Found 3/8" iron bar 12" below ground surface in center of N-S fire lane. Placed plastic cap PS33986 on it. Set nails in: 14" R. Pine N31W 62.55' "1/4S" * 22" R. Pine S54E 54.9' old blazes * 8" Maple N62E 26.5' mrd "1/4S NBT" 14" W. Pine S52W 36.05' do Bearings are magnetic. Distances are to nail with tag.	(MC) Set 5/8"x24" rebar with plastic cap MICH DNR PS33986, buried 12". Set measuring nails in: 16" R. Pine N42W 43.2' old blazes 10" R. Pine N69E 84.2' do 10" J. Pine N39E 83.5' mrd "MC NBT" 12" J. Pine N70W 41.6' do Bearings are magnetic. Distances are to nail with tag.
--	--

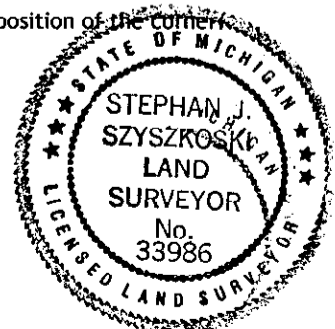

Signed by Stephan J. Szyszkoski  
 Surveyor's Michigan License No. 33986

Date 12/20/04