

MICHIGAN
DEPARTMENT OF CONSERVATION
FORESTRY DIVISION

LAND CORNER RECORD

T. 49N N.R. 11W


Luce COUNTY

DESCRIPTION OF CORNER Sec. Cor. common to Secs. 3-4-9-10

CORNER MONUMENT 1" pipe with 4" aluminum cap.

DATE MONUMENT PLACED AND WITNESSED 8-11-70

WITNESSES TO CORNER..... 12" Red Pine (S9 NBT) S53°W 49.6'

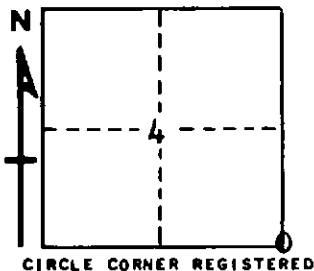

12" Red Pine (S10 NBT) S42°E 69.5'

AND

DESCRIPTION IN DETAIL AS TO HOW CORNER WAS LOCATED AND IDENTIFIED OR RESTORED.

This corner replaced as set by Marcus Schaaf, R.L.S.
Found 2" iron pipe in intersection of fire lanes to south and west.
Found two pine stump bottoms in proper position for recorded witnesses to
SE and SW of corner.

SURVEYOR'S SEAL

SIGNED *Billy D. Buckler*
Billy D. Buckler DATE 8-11-70
REGISTERED LAND SURVEYOR